

**INTERLOCAL AGREEMENT BETWEEN CITY OF REDMOND AND
CITY OF SAMMAMISH FOR LANDSCAPE MAINTENANCE
OF A PORTION OF SR 202**

THIS AGREEMENT is entered into between the City of Sammamish, a Washington city ("Sammamish") and the City of Redmond, a Washington City ("Redmond") for the purposes hereafter mentioned.

RECITALS

A. In 2009, the State of Washington completed road widening improvements to SR 202 from SR 520 to 192nd Ave N.E. A portion of these improvements are in Redmond and a portion of these improvements are in Sammamish. The improvements included landscaped medians and other landscaped areas within and adjacent to the improved roadway.

B. Under an interlocal agreement between Redmond and the Washington State Department of Transportation ("WSDOT"), Redmond has maintained the landscaping in both Redmond and a portion of Sammamish since installation by the state. The interlocal agreement between Redmond and WSDOT expired June 30, 2011.

C. Sammamish and Redmond deem it to be in the best interest of both cities that Redmond continues to maintain the landscaping as provided in Redmond's interlocal agreement with WSDOT. Redmond has expressed a willingness to do so and Sammamish has expressed a willingness to pay Redmond to do so. The parties wish to reduce their agreement to writing.

AGREEMENT

IN CONSIDERATION OF the terms and conditions set forth below, the parties agree as follows:

1. **Redmond to Maintain Landscaping.** Redmond agrees to provide all labor, equipment, and materials necessary to perform routine maintenance of the landscaping in the shaded areas shown on the as-built Roadside Planting Plans attached to this Agreement as Exhibit A and incorporated herein by this reference as if set forth in full. Routine maintenance means and includes those services described on the Maintenance Schedule attached to this Agreement as Exhibit B and incorporated herein by this reference as if set forth in full. With respect to the irrigation system in the landscaped areas, routine maintenance includes main line repairs, lateral line repairs, and sprinkler head repairs. Routine maintenance of the irrigation system does not include repair or replacement of valves, valve wiring, controllers, control cabinets, double-check valves, and the Maxicom CCU(s), which shall remain the sole responsibility of Sammamish. Routine maintenance also does not include maintenance or repair of streetlights, fences, retaining walls, and hard surfaces (concrete/asphalt). The frequency of maintenance shall be as provided in the Maintenance Schedule. Items marked "NIC" on the Maintenance Schedule are not included in this Agreement.

2. **Payment by Sammamish.** Sammamish agrees to pay Redmond on an annual basis for the maintenance services provided under Section 1 of this Agreement. For the remainder of 2011, the payment shall be determined by multiplying the sum of \$14.75 by the number of calendar days remaining in the year as of the effective date of this Agreement. The entire amount due for 2011 shall be paid on or before the 15th day of the month following the effective date of this Agreement. For 2012, the annual payment shall be \$5,383.75, which shall be due on or before the 15th day of January, 2012. If this Agreement is renewed for the calendar year 2013, the amount of the payment shall be increased over the 2012 amount by an amount equal to the increase in the Consumer Price Index - All Urban Consumers (CPI-U) for the Seattle-Tacoma-Bremerton Area from June 2011 to June 2012. If this Agreement is renewed thereafter, the amount of the payment shall be increased each January 1 by an amount equal to the increase in the CPI-U during the most recent June to June period. Annual payments in 2013 and after shall be due and payable on or before January 15 of the renewal year.

3. **Duration of Agreement.** This Agreement shall become effective upon execution by both parties and shall be for an initial term ending December 31, 2012. This Agreement shall thereafter renew on a year-to-year basis unless either party gives notice to the other of its intent not to renew at least sixty days prior to December 31 of the year in which notice is given.

4. **Right of Entry.** Sammamish hereby grants Redmond access to the shaded areas shown on Exhibit A for the purpose of performing maintenance pursuant to the terms of this Agreement. During such times as Redmond is performing maintenance, Redmond shall be responsible for any necessary traffic control.

5. **Indemnification.**

5.1 Redmond agrees to indemnify, hold harmless, and defend Sammamish, its officers and employees, from and against any and all costs, claims, judgments and/or awards of damages (both to persons and/or property), arising out of or resulting from Redmond's negligence in the performance of this Agreement. Redmond will not be required to indemnify, hold harmless or defend Sammamish if the claim, suit, or action for injuries, death or damages (both to persons and/or property) is the result of the sole negligence of Sammamish, its officers or employees.

5.2 Sammamish agrees to indemnify, hold harmless, and Redmond, its officers and employees, from and against any and all costs, claims, judgments and/or awards of damages (both to persons and/or property), arising out of or resulting from Sammamish's negligence in the performance of this Agreement. Sammamish will not be required to indemnify, hold harmless or defend Redmond if the claim, suit, or action for injuries, death or damages (both to persons and/or property) is the result of the sole negligence of Redmond, its officers or employees.

5.3 Where a claim, suit, or action results from the concurrent negligence of Sammamish and Redmond, or their officers or employees, the indemnity provisions of this section shall be valid and enforceable only to the extent of each party's, or their officers' or employees' negligence.

5.4 This indemnity shall survive termination or expiration of this Agreement for any claim, suit, or action for injuries, death, or damage occurring prior to such termination or expiration.


6. **Termination.** Either party may terminate this Agreement during its term or any renewal term thereof for breach of the Agreement by the other party, provided, that such termination shall not become effective if, within thirty (30) days from the date notice of termination is given, the non-terminating party cures the breach or, if such breach cannot be cured within thirty (30) days, commences cure within that time period and pursues the cure to completion.

7. **Property.** Sammamish and Redmond will not acquire any joint property under this Agreement. Performance of services by Redmond shall not result in any title to the landscaped areas passing to Redmond. Payment by Sammamish shall not result in title to any Redmond equipment or materials passing to Sammamish.

8. **Administration.** No separate legal entity is created by this Agreement. This Agreement shall be jointly administered by the Park and Recreation Director of Redmond and the Public Works Director of Sammamish.

9. **Notices.** Notices under this Agreement shall be provided in writing to the parties at the following addresses:

Redmond


Craig Larson
Director of Parks and Recreation
City of Redmond
15970 NE 85th Street
P.O. Box 97010
Mail Stop 4NPK
Redmond, WA 98073

Sammamish

Laura Philpot
Public Works Director
City of Sammamish
801 228th Ave. S.E.
Sammamish, WA 98075

Notices shall be given by personal delivery or by mail and, if given by mail, shall be deemed received three (3) business days after the same is deposited in the United States Mail, postage prepaid, addressed as provided above.

10. **Amendments.** This Agreement may be amended only by a written instrument signed by both parties.


11. **Listing on Web Sites.** Pursuant to RCW 39.34.040, Redmond and Sammamish shall each list this Agreement by subject on their respective web sites.

12. Entire Agreement. This Agreement constitutes the entire agreement between the parties regarding the maintenance of the landscaping described in Section 1 hereof and supersedes all prior negotiations or understandings.


AGREED TO by the parties on the dates set forth below.

CITY OF REDMOND

CITY OF SAMMAMISH



Mayor John Marchione
Date: 9/1/11
ATTEST:



City Manager Ben Yazici
Date: July 19, 2011
ATTEST:




City Clerk Michelle McGehee, CMC



City Clerk Melonie Anderson

APPROVED AS TO FORM:

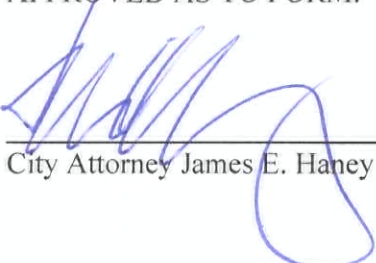

City Attorney James E. Haney

APPROVED AS TO FORM:

City Attorney Bruce L. Disend

EXHIBIT A

T.25N. R.5E. W.M.











| QUANTITY TAB - THIS SHEET ONLY | | |
|--------------------------------|------------------------------|----------|
| SYMBOL | ITEM | QUANTITY |
| | MIX M - 4' D.C. | M |
| | COMPACT OREGON GRAPE | 33 |
| | WATANABE VIBURNUM * | 12 |
| | BARK OR WOOD CHIP MULCH (CY) | 6.0 |
| | ANUR MAPLE - 20' D.C. (TYP) | 4 |

* PLANT YATAMABE VIBURNUM IN GROUPS OF 3 IN A STRAIGHT LINE DOWN THE CENTER OF THE MEDIAN BETWEEN AMUR MAPLES.

NOTES:

1. BARK OR WOOD CHIP MULCH SHALL BE PLACED AT A 2" DEPTH IN MEDIANS AND IN PLANTING AREAS BETWEEN CURB AND SIDEWALK IN STAGE 1 ONLY.
2. SHRUBS WITHIN PLANTING MIXES OCCUR THROUGHOUT ENTIRE PLANTING AREA, INCLUDING UNDER TREES AND TREE-LIKE SHRUBS.

LEGEND


 WALL
 RIGHT OF WAY
 LIMITED ACCESS
 GUARDRAIL
 CITY OF REDMOND
 CITY OF SANJUANISH
 KING COUNTY
 ADJACENT PROPERTY OWNER

BEGIN SAFE-TEA LU
BEGIN STPF-0202(047)
BEGIN STPU-0202(047)
BEGIN PROJECT
MP 8.00
STA. L115+00


SR 520-OFF-RAMP

TH-BC2-01

AS-BUILT
FOR REFERENCE ONLY

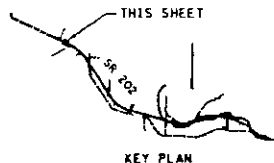


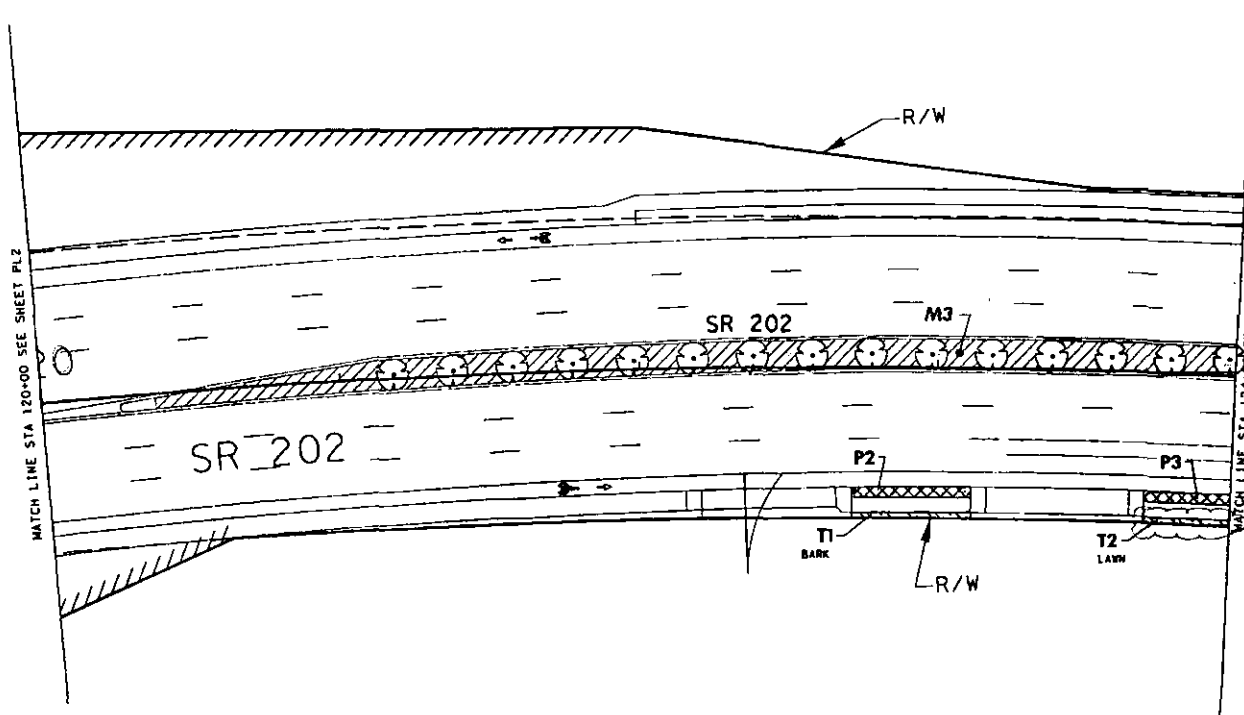
0 20 40
SCALE IN FEET

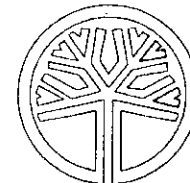







STATE OF
WASHINGTON
REGISTERED
LANDSCAPE ARCHITECT

DAVID S. PETERSON
CERTIFICATE NO. 476
DATE: _____

| | | | | | | | | | | |
|---------------|--|--|--|----------------------|--|---|--|--|--|--------------------------------------|
| FILE NAME | | T:\42006\XL3278 - SR 520 SAHALEE PLANT EST\XL3278\CA0VP58\Shoreline for Landscape-municipalities.dgn | | FED.AID PROJ.NO. | |  Washington State Department of Transportation | | SR 520 SR 520 TO SAHALEE WAY STAGE 2 PLANT ESTABLISHMENT YEARS 2-4 | | PL01 PL1 SHEET OF SHEETS |
| TIME | | 5:51:23 PM | | 10 WASH | | | | ROADSIDE PLANTING PLAN | | |
| DATE | | 10/2/2008 | | JOB NUMBER 04A059 | | | | | | |
| DESIGNED BY | | A. SAWICH | | LOCATION NO. | | | | | | |
| ENTERED BY | | K. McLEAN | | DATE | | | | | | |
| CHECKED BY | | K. McLEAN | | P.E. STAMP NO. | | | | | | |
| PROJ. ENGR. | | D. EDWARDS | | DATE | | | | | | |
| REGIONAL ADM. | | L. ENG | | P.E. STAMP NO. | | | | | | |
| REVISION | | | | DATE | | | | | | |




| QUANTITY TAB - THIS SHEET ONLY | | | | |
|---|--------------------------------|----------|-----|-----|
| SYMBOL | ITEM | QUANTITY | | |
| MIX M - 4" O.C. | | M3 | | |
|  | COMPACT OREGON GRAPE | 127 | | |
|  | WATANABE VIBURNUM * | 54 | | |
| BARK DR WOOD CHIP MULCH (CY) | | 21.0 | | |
| MIX P - 4" O.C. ** | | P3 | P2 | P3 |
|  | COMPACT OREGON GRAPE | 13 | 4 | 3 |
|  | PRIVET HONEYSUCKLE | 20 | 5 | 4 |
| BARK DR WOOD CHIP MULCH (CY) | | 60.0 | 1.0 | 0.5 |
| MIX T | | T1 | T2 | |
|  | LAWN (SY) | | | 6.7 |
| BARK DR WOOD CHIP MULCH (CY) | | 0.5 | | |
|  | AMUR MAPLE - 20' O.C. (TYP) | 15 | | |

•• PLANT COMPACT OREGON GRAPE AND
PRIVET HONEYSUCKLE IN GROUPS OF
3 TO 7 PLANTS







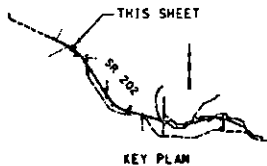

NOTES:


1. MIX T GROUND TREATMENT VARIES TO MATCH ADJACENT LANDSCAPE. SEE QUANTITY TAB FOR AREA AND TREATMENT.
2. BARK OR WOOD CHIP MULCH SHALL BE PLACED AT A 2" DEPTH IN MEDJANS AND IN PLANTING AREAS BETWEEN CURB AND SIDEWALK IN STAGE 1 ONLY.
3. SHRUBS WITHIN PLANTING MIXES OCCUR THROUGHOUT ENTIRE PLANTING AREA, INCLUDING UNDER TREES AND TREE-LIKE SHRUBS.

AS-BUILT
FOR REFERENCE ONLY




LEGEND

- | | | | |
|---|----------------|---|---------------------------|
|  | WALL |  | CITY OF REDMOND |
|  | RIGHT OF WAY |  | CITY OF SAMMAMISH |
|  | LIMITED ACCESS |  | KING COUNTY |
|  | GUARDRAIL |  | ADJACENT PROPERTY OWNERS? |

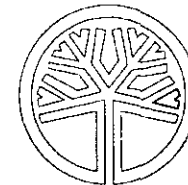

STATE OF
WASHINGTON
REGISTERED
LANDSCAPE ARCHITECT


DAVID S. PETERSON
CERTIFICATE NO. 476
DATE: _____

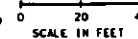

Washington State
Department of Transportation

SR 202
SR 520 TO SAHALEE WAY STAGE 2
PLANT ESTABLISHMENT YEARS 2-4

ROADSIDE PLANTING PLAN

| | | | | | | | | | | | | | | | | | | | |
|--|--|--|--|--|--|--|--|--|--|--|--|---|--|---|--|---|--|---------------------------------------|--|
| FILE NAME T:\42006\XL3278 - SR 202 SAHLEE PLANT EST\XL3278\CADVP\$AESheetaFor Landscape SHIS 3 & 4.dgn TIME 6:03:46 PM DATE 10/27/2008 DESIGNED BY A. SAWICH ENTERED BY K. McLEAN CHECKED BY B. McLEAN PROJ. EMGR. D. EDWARDS REGIONAL ADM. L. ENO REVISION DATE BY | | | | | | | | | | REGION NO. 10 WASH JOB NUMBER CONTRACT NO. LOCATION NO. DATE P.E. STAMP BOX | | STATE FED.AID PROJ.NO. DATE P.E. STAMP BOX | |  Washington State Department of Transportation | | SR 202 SR 520 TO SAHLEE WAY STAGE 2 PLANT ESTABLISHMENT YEARS 2-4 ROADSIDE PLANTING PLAN | | PL013 PL3 SHEET OF SHEETS | |
|--|--|--|--|--|--|--|--|--|--|--|--|---|--|---|--|---|--|---------------------------------------|--|

T.25N. R.5E. W.M.

| QUANTITY TAB - THIS SHEET ONLY | | | | |
|--------------------------------|------|----------|------|------|
| SYMBOL | ITEM | QUANTITY | | |
| MIX M - 4' O.C. | | M30 | | |
| COMPACT OREGON GRAPE | | 28 | | |
| WATANABE VIBURNUM * | | 12 | | |
| BARK OR WOOD CHIP MULCH (CY) | | 3.0 | | |
| MIX P - 4' O.C. ** | | | P5 | P6 |
| COMPACT OREGON GRAPE | | | 7 | 7 |
| PRIVET HONEYSUCKLE | | | 8 | 8 |
| BARK OR WOOD CHIP MULCH (CY) | | | 1.5 | 1.5 |
| MIX T | | | T3 | T4 |
| LAWN (SY) | | | 15.1 | 14.8 |
| | | | 47.7 | |

* PLANT WATANABE VIBURNUM IN GROUPS OF 3 IN A STRAIGHT LINE DOWN THE CENTER OF THE MEDIAN BETWEEN AMUR MAPLES.


** PLANT COMPACT OREGON GRAPE AND PRIVET HONEYSUCKLE IN GROUPS OF 3, 5, 7 OR 9 PLANTS

NOTES:

1. MIX T GROUND TREATMENT VARIES TO MATCH ADJACENT LANDSCAPE. SEE QUANTITY TAB FOR AREA AND TREATMENT.
2. BARK OR WOOD CHIP MULCH SHALL BE PLACED AT A 2" DEPTH IN MEDIANS AND IN PLANTING AREAS BETWEEN CURBS AND SIDEWALK IN STAGE 1 ONLY.
3. SHRUBS WITHIN PLANTING MIXES OCCUR THROUGHOUT ENTIRE PLANTING AREA, INCLUDING UNDER TREES AND TREE-LIKE SHRUBS.

LEGEND


- WALL
- RIGHT OF WAY
- LIMITED ACCESS
- GUARDRAIL

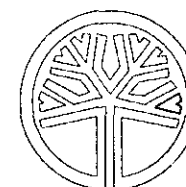

STATE OF
WASHINGTON
REGISTERED
LANDSCAPE ARCHITECT

DAVID S. PETERSON
CERTIFICATE NO. 476
DATE:

AS-BUILT
FOR REFERENCE ONLY

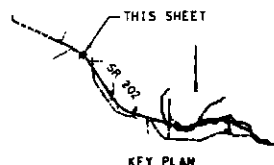

LEGEND

- WALL
- RIGHT OF WAY
- LIMITED ACCESS
- GUARDRAIL
- CITY OF REDMOND
- CITY OF SANMAMISH
- KING COUNTY
- ADJACENT PROPERTY OWNERS

0 20 40
SCALE IN FEET

FILE NAME: T:\412006\XL3278 - SR 202 SAHLEE PLANT EST\XL3278\CAD\PS&FSheet1&For Landscape SHTS 3 & 4.dgn

TIME: 6:03:49 PM
DATE: 10/27/2008

DESIGNED BY: A. SAWICH
ENTERED BY: K. McLEAN
CHECKED BY: B. MacLAREN
PROJ. ENGR.: D. EDWARDS
REGIONAL ADM.: L. ENG

REVISION

DATE

BY

REGION: STATE
NO. WASH
JOB NUMBER
04A059
CONTRACT NO.

FED. AID PROJ. NO.

LOCATION NO.

P.E. STAMP BOX DATE

P.E. STAMP BOX DATE

Washington State
Department of Transportation

SR 202
SR 520 TO SAHLEE WAY STAGE 2
PLANT ESTABLISHMENT YEARS 2-4


ROADSIDE PLANTING PLAN

PL014

PL4

SHEET
OF
SHEETS

T.25N. R.5E. W.M.

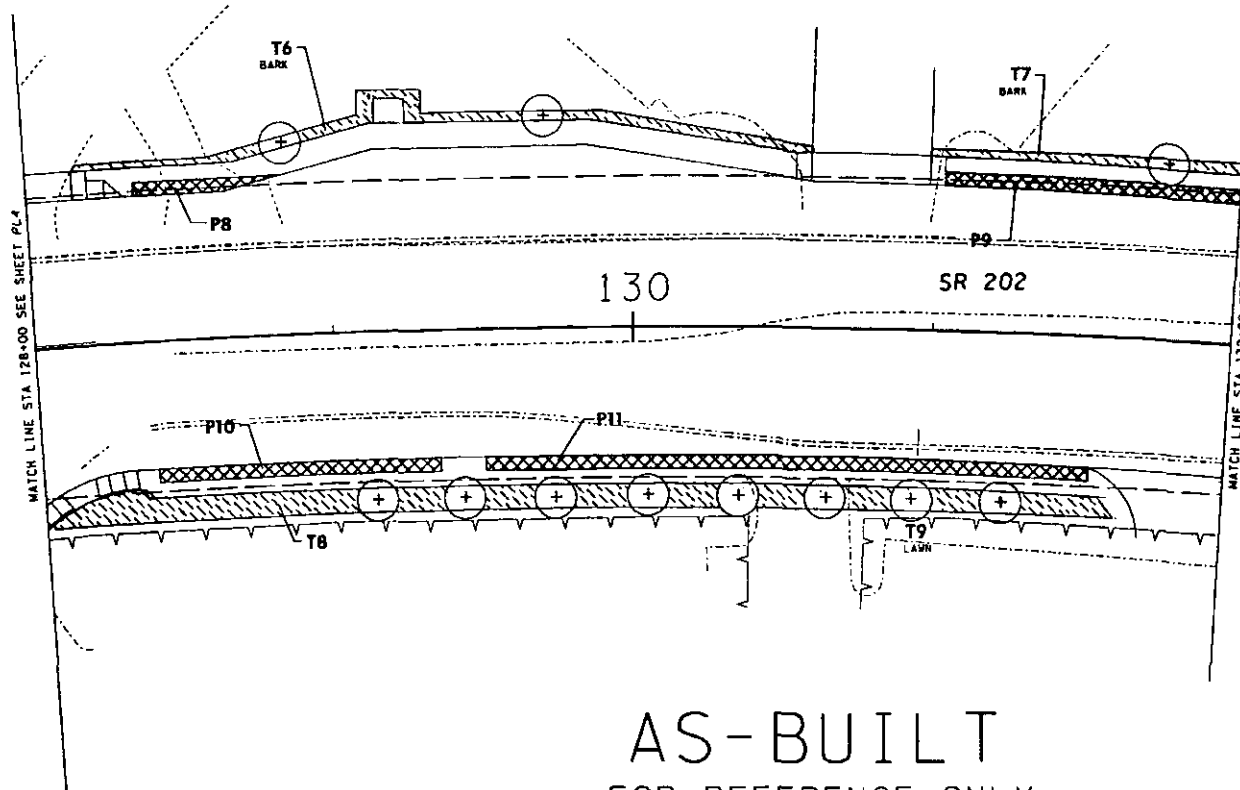

| QUANTITY TAB - THIS SHEET ONLY | | | | | | |
|--------------------------------|---|----------|-----|------|-----|--|
| SYMBOL | ITEM | QUANTITY | | | | |
| | | P8 | P9 | P10 | P11 | |
| MIX P - 4" O.C. ** | | | | | | |
| | COMPACT OREGON GRAPE | 4 | 12 | 11 | 25 | |
| | PRIVET HONEYSUCKLE | 5 | 12 | 12 | 24 | |
| | BARK OR WOOD CHIP MULCH (CY) | 1.0 | 3.0 | 3.0 | 5.0 | |
| MIX T | | T6 | T7 | T8 | | |
| | COMPACT OREGON GRAPE | | | 132 | | |
| | SOIL AMENDMENT WITH GROUND BARK (CY) | 8.0 | 3.0 | 18.0 | | |
| | FINE COMPOST (CY) | 3.0 | 1.0 | 1.0 | | |
| | BARK OR WOOD CHIP MULCH (CY) | 8.0 | 3.0 | 1.5 | | |
| + | 'EMERALD QUEEN' NORWAY MAPLE 30" O.C. (TYP) | 11 | | | | |

** PLANT COMPACT OREGON GRAPE AND PRIVET HONEYSUCKLE IN GROUPS OF 3, 5, 7 OR 9 PLANTS


NOTES:

1. MIX T GROUND TREATMENT VARIES TO MATCH ADJACENT LANDSCAPE. SEE QUANTITY TAB FOR AREA AND TREATMENT.
2. BARK OR WOOD CHIP MULCH SHALL BE PLACED AT A 2" DEPTH IN MEDIANS AND IN PLANTING AREAS BETWEEN CURB AND SIDEWALK IN STAGE 1 ONLY.
3. IN AREAS WITH LAWN AND STREET TREES, SEE LAWN EDGING AND TREE PIT PLANTING DETAILS, SHEET POS.
4. SHRUBS WITHIN PLANTING MIXES OCCUR THROUGHOUT ENTIRE PLANTING AREA, INCLUDING UNDER TREES AND TREE-LIKE SHRUBS.
5. FOR T8 AND T9 PLANT 'EMERALD QUEEN' NORWAY MAPLE WITHIN EXISTING PLANTING. SEE TREE PIT PLANTING DETAIL ON SHEET POS. APPLY 1" FINE COMPOST (DO NOT INCORPORATE) AND 3" BARK OR WOOD CHIP MULCH.

LEGEND


- WALL
- RIGHT OF WAY
- LIMITED ACCESS
- GUARDRAIL

AS-BUILT
FOR REFERENCE ONLY

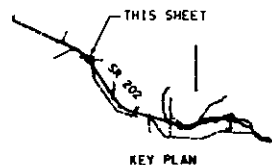

CITY OF REDMOND
CITY OF SAMBOKAMISH
KING COUNTY
ADJACENT PROPERTY OWNER

0 20 40
SCALE IN FEET

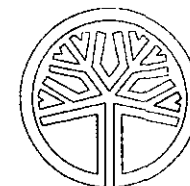


STATE OF
WASHINGTON
REGISTERED
LANDSCAPE ARCHITECT

DAVID S. PETERSON
CERTIFICATE NO. 476
DATE:

| | | | | | |
|---|-----------------------|-----------------------|------------------------|--|-----------------|
| FILE NAME: T:\M2006\XL3278 - SR 202 SAHALEE PLANT EST\XL3278\CA\VP5&6\Sheets\For Landscape\municipal\p115.dgn | | | | PLOT5 | |
| TIME: 5:51:26 PM | DATE: 10/2/2008 | REGION: 10 | STATE: WASH | FED.AID PROJ.NO. | PL5 |
| DESIGNED BY: A. SAWICH | ENTERED BY: K. McLEAH | CHECKED BY: B. McLEAH | PROJ. ENGR: D. EDWARDS | REGIONAL ADM. L. ENG | SHEET OF SHEETS |
| REVISION | | | | DATE | BY |
| CONTRACT NO. 04A059 | | | | LOCATION NO. | |
| P.E. STAMP BOX | | | | P.E. STAMP BOX | |
| Washington State Department of Transportation | | | | SR 202 SR 520 TO SAHALEE WAY STAGE 2 PLANT ESTABLISHMENT YEARS 2-4 ROADSIDE PLANTING PLAN | |

T.25N. R.6E. W.M.

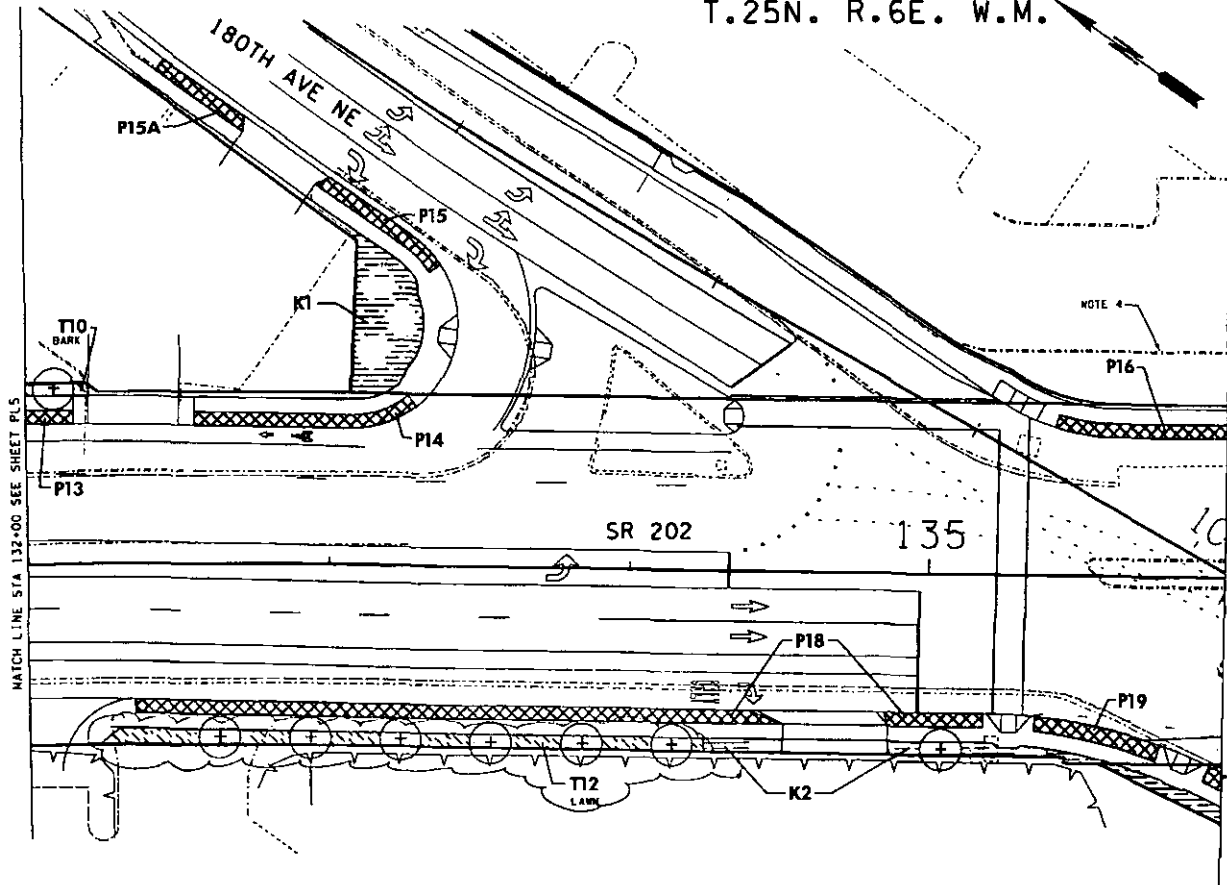


| QUANTITY TAB - THIS SHEET ONLY | | | | | | | | | |
|--------------------------------|---|----------|-----|-----|------|-----|-----|-----|--|
| SYMBOL | ITEM | QUANTITY | | | | | | | |
| | | P13 | P14 | P15 | P15A | P16 | P18 | P19 | |
| MIX P - 4" O.C. ** | COMPACT OREGON GRAPE | 2 | 9 | 5 | 3 | 6 | 43 | 8 | |
| | BARK OR WOOD CHIP MULCH (CY) | 0.5 | 2.0 | 1.5 | 0.5 | 1.5 | 6.5 | 1.5 | |
| MIX T | | 710 | | | | | | | |
| | LAWN (SY) SEE NOTE 3 | 1.0 | | | | | | | |
| | SOIL AMENDMENT WITH GROUND BARK (CY) | 1.0 | | | | | | | |
| | FINE COMPOST (CY) | 0.5 | | | | | | | |
| | BARK OR WOOD CHIP MULCH | 0.5 | | | | | | | |
| MIX K - 4" O.C. | | K1 | | | | | | | |
| | COMPACT OREGON GRAPE | 47 | | | | | | | |
| | 'ELMA' ROCK ROSE | 24 | | | | | | | |
| | SALAL | 8 | | | | | | | |
| | SOIL AMENDMENT WITH GROUND BARK (CY) | 11.0 | | | | | | | |
| | FINE COMPOST (CY) | 6.0 | | | | | | | |
| | BARK OR WOOD CHIP MULCH | 11.0 | | | | | | | |
| | 'EMERALD QUEEN' NORWAY MAPLE - 30" O.C. (TYP) | 8 | | | | | | | |
| | KDUSA ODDWOOD SPACING AS SHOWN (TYP) | | | | | | | | |

** PLANT COMPACT OREGON GRAPE AND PRIVET HONEYSUCKLE IN GROUPS OF 3, 5, 7 OR 9 PLANTS

NOTES:

- MIX T GROUND TREATMENT VARIES TO MATCH ADJACENT LANDSCAPE. SEE QUANTITY TAB FOR AREA TREATMENT.
- BARK OR WOOD CHIP MULCH SHALL BE PLACED AT A 2" DEPTH IN MEDIANS AND IN PLANTING AREAS BETWEEN CURB AND SIDEWALK IN STAGE 1 ONLY.
- IN AREAS WITH LAWN AND STREET TREES, SEE LAWN EDGING AND TREE PIT PLANTING DETAILS, SHEET PDS.
- FORCE ACCOUNT ROADSIDE RESTORATION FOR TEMPORARY EASEMENT; PLANTING SHALL NOT BLOCK PROPERTY SIGNAGE.
- SHRUBS WITHIN PLANTING MIXES OCCUR THROUGHOUT ENTIRE PLANTING AREA, INCLUDING UNDER TREES AND TREE-LIKE SHRUBS.
- FOR T12 PLANT 'EMERALD QUEEN' NORWAY MAPLE WITHIN EXISTING PLANTING. SEE TREE PIT PLANTING DETAIL ON SHEET PDS. APPLY 3" FINE COMPOST (DO NOT INCORPORATE) AND 3" BARK OR WOOD CHIP MULCH.

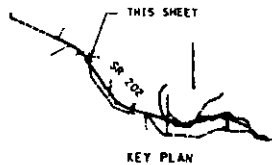


AS-BUILT
FOR REFERENCE ONLY

LEGEND

- WALL
- RIGHT OF WAY
- LIMITED ACCESS
- GUARDRAIL
- CITY OF REDMOND
- CITY OF SAMOHAMISH
- KING COUNTY
- ADJACENT PROPERTY OWNER


0 20 40
SCALE IN FEET

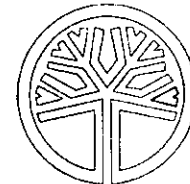

STATE OF
WASHINGTON
REGISTERED
LANDSCAPE ARCHITECT

DAVID S. PETERSON
CERTIFICATE NO. 476
DATE:

| | | | | | | | | | | | | | |
|--------------------------------|--|---------------|--|-------------------|--|------------------|--|--|--|-------------------------------|--|---------|--|
| FILE NAME *****DESIGNFILE***** | | REGION NO. 10 | | STATE WASH | | FED.AID PROJ.NO. | | | | SR 202 | | PL06 | |
| TIME 01100 | | | | | | | | | | SR 520 TO SAMALEE WAY STAGE 2 | | PL6 | |
| DATE 0000000000 | | | | | | | | | | PLANT ESTABLISHMENT YEARS 2-4 | | SHEET 1 | |
| DESIGNED BY A. SAWICH | | | | JOB NUMBER 04A059 | | LOCATION NO. | | | | ROADSIDE PLANTING PLAN | | SHEET 2 | |
| ENTERED BY K. McLEAN | | | | | | | | | | | | SHEET 3 | |
| CHECKED BY B. MacLAREN | | | | | | | | | | | | SHEET 4 | |
| PROJ. ENGR. D. EDWARDS | | | | | | | | | | | | SHEET 5 | |
| REGIONAL ADM. L. ENG | | | | | | | | | | | | SHEET 6 | |
| REVISION | | DATE | | BY | | | | | | | | | |

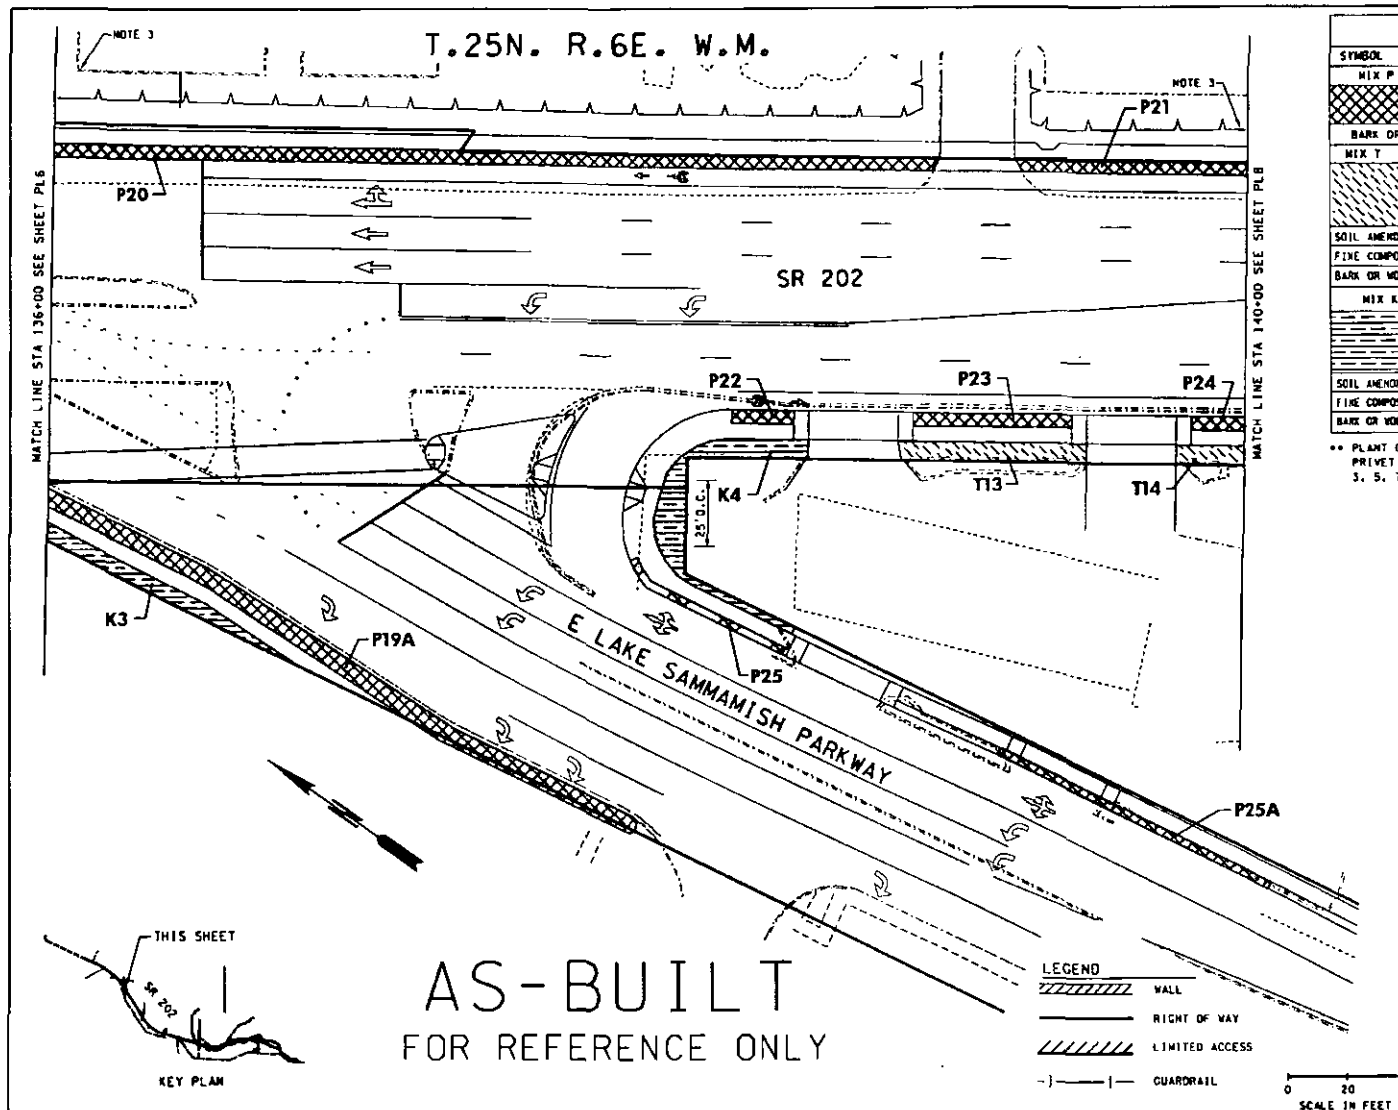

| QUANTITY TAB - THIS SHEET ONLY | | | | | | | | | | | |
|--------------------------------------|------|----------|-----|-----|-----|-----|-----|-----|------|------|------|
| SYMBOL | ITEM | QUANTITY | | | | | | | | P25A | P25B |
| | | P19A | P20 | P21 | P22 | P23 | P24 | P25 | P25A | | |
| MIX P - 4" O.C. ** | | 31 | 43 | 9 | 2 | 6 | 1 | 8 | 15 | | |
| COMPACT OREGON GRAPE | | 34 | 46 | 10 | 2 | 7 | 2 | 10 | 13 | | |
| PRIVET HONEYSUCKLE | | | | | | | | | | | |
| BARK OR WOOD CHIP MULCH (CY) | | 8.0 | 8.0 | 2.0 | 1.0 | 1.5 | 0.5 | 1.0 | 1.5 | | |
| MIX T | | | | | | | | | | | |
| | | | | | | | | | | | |
| SOIL AMENDMENT WITH GROUND BARK (CY) | | 4.0 | 1.5 | | | | | | | | |
| FINE COMPOST (CY) | | 1.0 | 1.0 | | | | | | | | |
| BARK OR WOOD CHIP MULCH (CY) | | 4.0 | 1.5 | | | | | | | | |
| MIX K - 4" O.C. | | 83 | 84 | | | | | | | | |
| COMPACT OREGON GRAPE | | 16 | 26 | | | | | | | | |
| 'ELWA' ROCK ROSE | | 8 | 14 | | | | | | | | |
| SALAL | | 3 | 5 | | | | | | | | |
| SOIL AMENDMENT WITH GROUND BARK (CY) | | 4.0 | 6.0 | | | | | | | | |
| FINE COMPOST (CY) | | 1.5 | 2.0 | | | | | | | | |
| BARK OR WOOD CHIP MULCH (CY) | | 4.0 | 6.0 | | | | | | | | |

** PLANT COMPACT OREGON GRAPE AND PRIVET HONEYSUCKLE IN GROUPS OF 3, 5, 7 OR 9 PLANTS

NOTES:

1. MIX T GROUND TREATMENT VARIES TO MATCH ADJACENT LANDSCAPE. SEE QUANTITY TAB FOR AREA AND TREATMENT.
2. BARK OR WOOD CHIP MULCH SHALL BE PLACED AT A 2" DEPTH IN MEDIANS AND IN PLANTING AREAS BETWEEN CURB AND SIDEWALK IN STAGE 1 ONLY.
3. IN AREAS WITH LAWN AND STREET TREES, SEE LAWN EDGING AND TREE PIT PLANTING DETAILS, SHEET P05.
4. FORCE ACCOUNT ROADSIDE RESTORATION FOR TEMPORARY EASEMENT; PLANTING SHALL NOT BLOCK PROPERTY SIGNAGE.
5. SHRUBS WITHIN PLANTING MIXES OCCUR THROUGHOUT ENTIRE PLANTING AREA, INCLUDING UNDER TREES AND TREE-LIKE SHRUBS.


CITY OF REDMOND
CITY OF SAMMAMISH
KING COUNTY

ADJACENT PROPERTY OWNER

STATE OF
WASHINGTON
REGISTERED
LANDSCAPE ARCHITECT

DAVID S. PETERSON
CERTIFICATE NO. 476
DATE: _____

| | | | | | | | | | |
|--|--|------------------------|--|------------------------------|--|-------------------------------|--|------------------------|--|
| FILE NAME: T:\42006\XL3278 - SR 202 SAHLEE PLANT EST\XL3278\CAD\PSAFS\Sheets\For Landscape-municipal\ies.dgn | | REGION: 10 WASH | | STATE: WASH | | FED.A10 PROJ.NO. | | PLOT# | |
| TIME: 5:51:32 PM | | JOB NUMBER: 04A059 | | CONTRACT NO. | | LOCATION NO. | | PL7 | |
| DATE: 10/2/2008 | | DESIGNED BY: A. SAWICH | | ENTERED BY: K. McLEAN | | CHECKED BY: B. MacLAREN | | SHEET | |
| PROJ. ENGR: D. EDWARDS | | REGIONAL ADM: L. ENG | | REVISION | | DATE | | BY | |
| Washington State Department of Transportation | | SR 202 | | SR 520 TO SAHLEE WAY STAGE 2 | | PLANT ESTABLISHMENT YEARS 2-4 | | ROADSIDE PLANTING PLAN | |

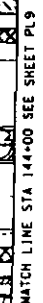

THIS SHEET

SP 202

KEY PLAN

0 20 40
SCALE IN FEET

- DAVID S. PETERSON
CERTIFICATE NO. 476
DATE: _____






 

[illegible]




DAVID S. PETERSON
CERTIFICATE NO. 476
DATE: _____

NOTES:

- PLANT WATANABE YIBURNUM IN GROUPS OF 3 IN A STRAIGHT LINE DOWN THE CENTER OF THE MEDIAN BETWEEN AMUR MAPLES.
- PLANT COMPACT OREGON GRAPE AND PRIVATE HONEYSUCKLE IN GROUPS OF 3, 5, 7 OR 9 PLANTS
- SETBACK DISTANCE 6" MIN. BACK OF SIDEWALK


 WALL
 RIGHT OF WAY
 LIMITED ACCESS
 GUARDRAIL
 CITY OF REDMOND
 CITY OF SAMBAMAHISH
 KING COUNTY
 ADJACENT PROPERTY OWNER

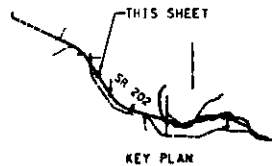



0 20 40
SCALE IN FEET

| | | | | | | | | | |
|---|--|--|--|--|--|--|--|---|--|
| FILE NAME T:\X2006\XL3278 - SR 202 SAHLEE PLANT EST\XL3278\CADVP58Sheets\For Landscaping-municipalities.dwg | | | | | | REGION STATE NO. WASH. | | PLOT#9 | |
| TIME 5:51:37 PM | | | | | | FED.AID PROJ.NO. | | PL9 | |
| DATE 10/2/2008 | | | | | | | | SHEET | |
| DESIGNED BY A SAWICH | | | | | | JOB NO. 10 | | OF | |
| ENTERED BY K. McLEAN | | | | | | 04A059 | | WASHT | |
| CHECKED BY B. MORGAN | | | | | | LOCATION NO. | | BY | |
| PROJ. ENGR. D. EDWARDS | | | | | | CONTRACT NO. | | SCALE | |
| REGIONAL ADM. L ENG | | | | | | DATE | | EXT. | |
| REVISION | | | | | | P.E. STAMP NO. | | P.E. STAMP NO. | |
| | | | | | | WASHINGTON STATE Department of Transportation | | SR 202 SR 520 TO SAHLEE WAY STAGE 2 PLANT ESTABLISHMENT YEARS 2-4 | |
| | | | | | | | | ROADSIDE PLANTING PLAN | |
| | | | | | | | | TOLERANCES | |

T.25N. R.6E. W.M.

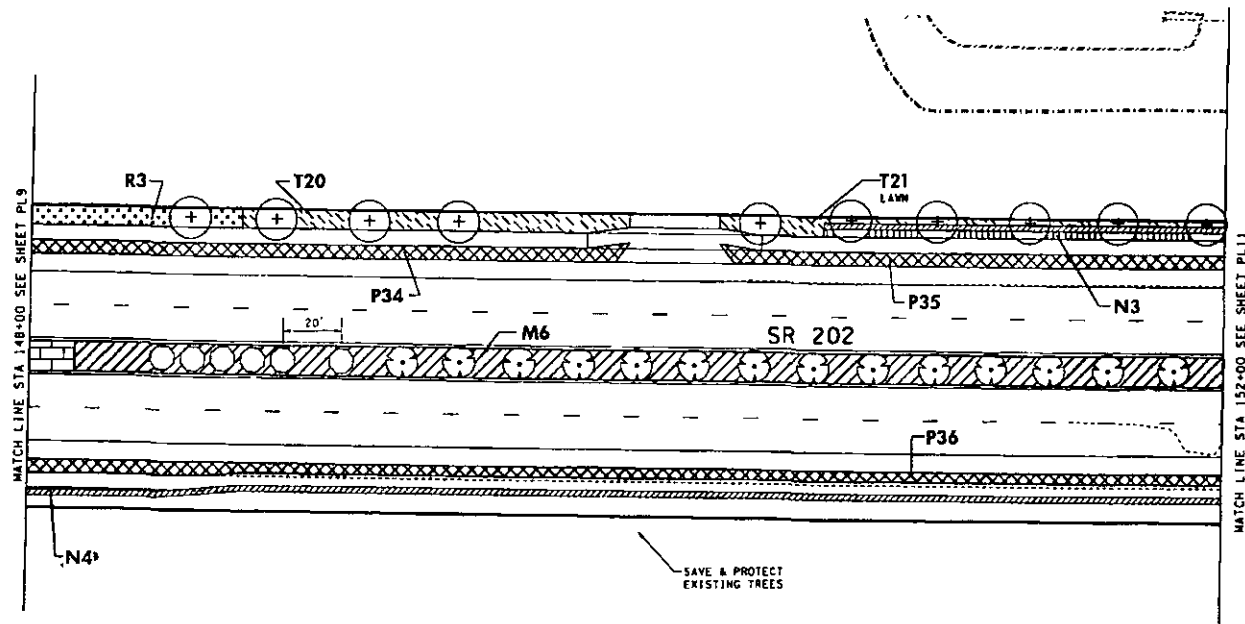

AS-BUILT
FOR REFERENCE ONLY

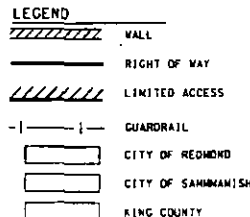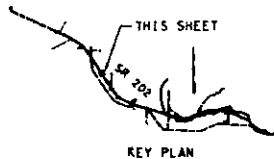

ADJACENT PROPERTY OWNER

NOTES:


- MIX 1 GROUND TREATMENT VARIES TO MATCH ADJACENT LANDSCAPE. SEE QUANTITY TAB FOR AREA AND TREATMENT.
- IN AREAS WITH LAWN AND STREET TREES. SEE LAWN EDGING AND TREE PIT PLANTING DETAILS, SHEET POS.
- SHRUBS WITHIN PLANTING MIXES OCCUR THROUGHOUT ENTIRE PLANTING AREA, INCLUDING UNDER TREES AND TREE-LIKE SHRUBS.
- SPACE BOSTON IVY EVENLY ALONG ENTIRE PLANTING AREA.

| QUANTITY TAB - THIS SHEET ONLY | | | | |
|--------------------------------|---|----------|------|------|
| SYMBOL | ITEM | QUANTITY | | |
| MIX N - 4' O.C. | | N6 | | |
| | COMPACT OREGON GRAPE | 132 | | |
| | WATANABE VIBURNUM * | 57 | | |
| | BARK OR WOOD CHIP MULCH (CY) | 35.0 | | |
| | TOPSOIL TYPE A (CY) | 118.0 | | |
| MIX P - 4' O.C. ** | | P34 | P35 | P36 |
| | COMPACT OREGON GRAPE | 39 | 23 | 59 |
| | PRIVET HONEYSUCKLE | 39 | 24 | 60 |
| | BARK OR WOOD CHIP MULCH (CY) | 8.0 | 7.0 | 13.0 |
| | TOPSOIL TYPE A (CY) | 27.0 | 23.0 | 45.0 |
| MIX T | | T20 | T21 | |
| | LAWN (SY) | 92.1 | 55.9 | |
| | SOIL AMENDMENT WITH GROUND BARK (CY) | 8.0 | 5.0 | |
| | FINE COMPOST (CY) | 0.5 | 0.5 | |
| | BARK OR WOOD CHIP MULCH (CY) | 0.5 | 0.5 | |
| MIX R - 6' O.C. | | R3 | | |
| | MOCK ORANGE | 1 | | |
| | HOOTKA ROSE | 2 | | |
| | OCEANSPRAY | 0 | | |
| | TALL OREGON GRAPE | 3 | | |
| | VINE MAPLE | 1 | | |
| | WESTERN SERVICEBERRY | 1 | | |
| | SOIL AMENDMENT WITH GROUND BARK (CY) | 4.0 | | |
| | FINE COMPOST (CY) | 1.0 | | |
| | BARK OR WOOD CHIP MULCH (CY) | 4.0 | | |
| MIX N - 3' O.C. *** | | N3 | N4 | |
| | BEACH STRAWBERRY | 11 | 4 | |
| | BOSTON IVY 'VEITCHII' | 2 | 1 | |
| | COMPACT OREGON GRAPE | 5 | 2 | |
| | SOIL AMENDMENT WITH GROUND BARK (CY) | 3.0 | 0.5 | |
| | FINE COMPOST (CY) | 1.0 | 0.5 | |
| | BARK OR WOOD CHIP MULCH (CY) | 3.0 | 0.5 | |
| | BURNING BUSH 10' O.C. (TYP) EXCEPT AS NOTED | | 6 | |
| | AMUR MAPLE 20' O.C. (TYP) | | 14 | |
| | 'EMERALD QUEEN' NORWAY MAPLE 30' O.C. (TYP) | | 10 | |

* PLANT WATANABE VIBURNUM IN GROUPS OF 3 IN A STRAIGHT LINE DOWN THE CENTER OF THE MEDIAN BETWEEN AMUR MAPLES.

** PLANT COMPACT OREGON GRAPE AND PRIVET HONEYSUCKLE IN GROUPS OF 3, 5, 7 OR 9 PLANTS

*** SETBACK DISTANCE 6" MIN. BACK OF SIDEWALK

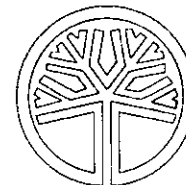

STATE OF
WASHINGTON
REGISTERED
LANDSCAPE ARCHITECT


DAVID S. PETERSON
CERTIFICATE NO. 476
DATE:

0 20 40
SCALE IN FEET

| | | | |
|---------------|--|----------|--|
| FILE NAME | T:\42006\XL3278 - SR 202 SAMALEE PLANT EST\XL3278\CAD\PS&E\Sheet\For Landscape\munic\pdf\files.dgn | | |
| TIME | 5:51:40 PM | | |
| DATE | 10/2/2008 | | |
| DESIGNED BY | A. SAWICH | REVISION | |
| ENTERED BY | K. McLEAN | DATE | |
| CHECKED BY | B. MacLAREN | BY | |
| PROJ. ENGR. | D. EDWARDS | DATE | |
| REGIONAL ADM. | L. ENG. | DATE | |

| | | |
|--|--|------------------------|
| FED.AID PROJ.NO. | | PL010 |
| CONTRACT NO. | 04A059 | PL10 |
| LOCATION NO. | | SHEET |
| DATE | | OF |
| P.E. STAMP BOX | | SHEET |
| Washington State Department of Transportation | SR 202 SR 520 TO SAMALEE WAY STAGE 2 PLANT ESTABLISHMENT YEARS 2-4 | ROADSIDE PLANTING PLAN |

T.25N. R.6E. W.M.

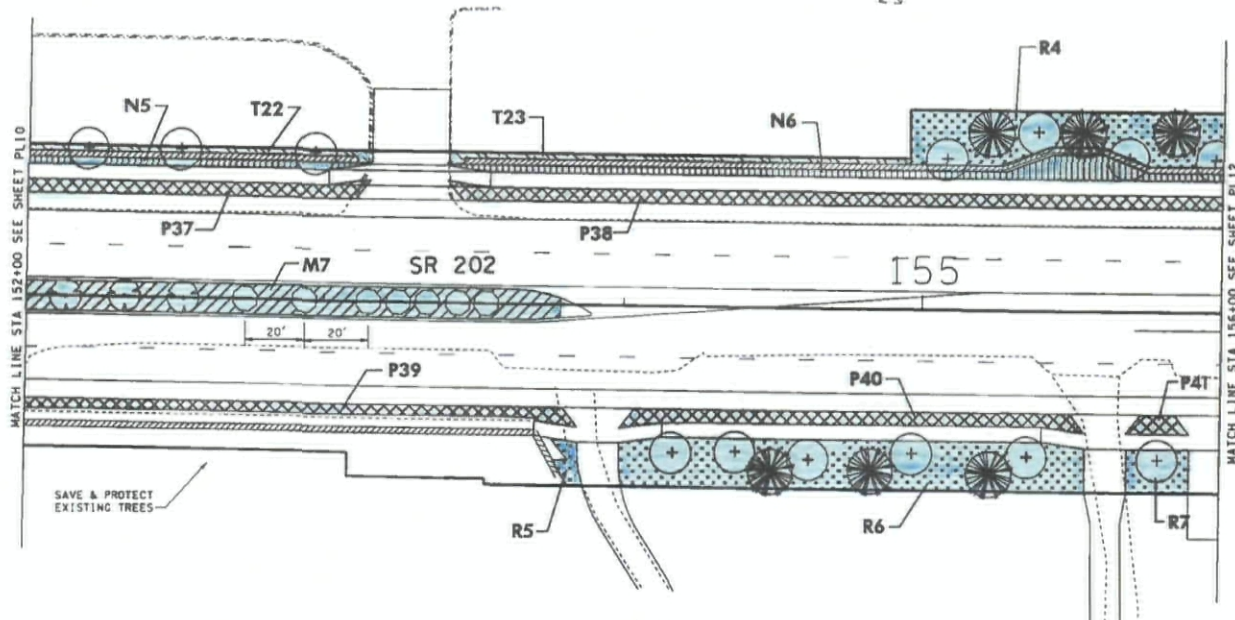

SAVE & PROTECT
EXISTING TREES

AS-BUILT
FOR REFERENCE ONLY



NOTES:

1. MIX T GROUND TREATMENT VARIES TO MATCH ADJACENT LANDSCAPE. SEE QUANTITY TAB FOR AREA AND TREATMENT.
2. IN AREAS WITH LAWN AND STREET TREES, SEE LAWN EDGING AND TREE PIT PLANTING DETAILS, SHEET POS.
3. SHRUBS WITHIN PLANTING MIXES OCCUR THROUGHOUT ENTIRE PLANTING AREA, INCLUDING UNDER TREES AND TREE-LIKE SHRUBS.
4. SPACE BOSTON IVY EVENLY ALONG ENTIRE PLANTING AREA.

LEGEND

| | | | |
|--|----------------|--|-------------------------|
| | WALL | | CITY OF REDMOND |
| | RIGHT OF WAY | | CITY OF SAMMAMISH |
| | LIMITED ACCESS | | KING COUNTY |
| | GUARDRAIL | | ADJACENT PROPERTY OWNER |

* PLANT WATANABE VIBURNUM IN GROUPS OF 3 IN A STRAIGHT LINE DOWN THE CENTER OF THE MEDIAN BETWEEN AMUR MAPLES.

** PLANT COMPACT OREGON GRAPE AND PRIVET HONEYSUCKLE IN GROUPS OF 3, 5, 7 OR 9 PLANTS

*** SETBACK DISTANCE 6" MIN. BACK OF SIDEWALK

0 20 40
SCALE IN FEET

QUANTITY TAB - THIS SHEET ONLY

| SYMBOL | ITEM | QUANTITY | | | | |
|---------------------|---|----------|------|------|------|-----|
| MIX M - 4' O.C. | | M7 | | | | |
| | COMPACT OREGON GRAPE | 67 | | | | |
| | WATANABE VIBURNUM | 27 | | | | |
| | BARK OR WOOD CHIP MULCH (CY) | 16.0 | | | | |
| | TOPSOIL TYPE A (CY) | 54.0 | | | | |
| MIX P - 4' O.C. ** | | P37 | P38 | P39 | P40 | P41 |
| | COMPACT OREGON GRAPE | 16 | 36 | 21 | 23 | 1 |
| | PRIVET HONEYSUCKLE | 17 | 36 | 22 | 23 | 1 |
| | BARK OR WOOD CHIP MULCH (CY) | 5.0 | 10.0 | 5.0 | 6.0 | 0.5 |
| | TOPSOIL TYPE A (CY) | 16.0 | 35.0 | 18.0 | 21.0 | 1.5 |
| MIX T | | T22 | T23 | | | |
| | LAWN (SY) | 26.5 | 34.7 | | | |
| | SOIL AMENDMENT WITH GROUND BARK (CY) | 2.0 | 3.0 | | | |
| | FINE COMPOST (CY) | 0.5 | 0.5 | | | |
| | BARK OR WOOD CHIP MULCH (CY) | 0.5 | 0.5 | | | |
| MIX R - 6' O.C. | | R4 | R5 | R6 | R7 | |
| | MOCK ORANGE | 8 | 0 | 12 | 2 | |
| | HOOTKA ROSE | 13 | 0 | 19 | 3 | |
| | OCEANSPRAY | 0 | 0 | 0 | 0 | |
| | TALL OREGON GRAPE | 16 | 1 | 23 | 3 | |
| | VINE MAPLE | 9 | 1 | 12 | 0 | |
| | WESTERN SERVICEBERRY | 8 | 1 | 12 | 2 | |
| | SOIL AMENDMENT WITH GROUND BARK (CY) | 18.0 | 1.0 | 25.0 | 3.0 | |
| | FINE COMPOST (CY) | 6.0 | 0.5 | 8.0 | 1.0 | |
| | BARK OR WOOD CHIP MULCH (CY) | 18.0 | 1.0 | 25.0 | 3.0 | |
| MIX N - 3' O.C. *** | | N5 | N6 | | | |
| | BEACH STRAWBERRY | 9 | 21 | | | |
| | BOSTON IVY "WEITCHII" | 2 | 4 | | | |
| | COMPACT OREGON GRAPE | 4 | 9 | | | |
| | SOIL AMENDMENT WITH GROUND BARK (CY) | 3.0 | 6.0 | | | |
| | FINE COMPOST (CY) | 1.0 | 2.0 | | | |
| | BARK OR WOOD CHIP MULCH (CY) | 3.0 | 6.0 | | | |
| | BURKWOOD OSMANTHUS 10' O.C. (TYP) EXCEPT AS NOTED | 7 | | | | |
| | AMUR MAPLE 20' O.C. (TYP) | 3 | | | | |
| | 'EMERALD QUEEN' NORWAY MAPLE 30' O.C. (TYP) | 13 | | | | |
| | DOUGLAS FIR | 6 | | | | |



STATE OF
WASHINGTON
REGISTERED
LANDSCAPE ARCHITECT

DAVID S. PETERSON
CERTIFICATE NO. 476
DATE:

| | | | | | | | | | |
|---|--|----------------------|--|--------------|--|------------------|--|-----------------|--|
| FILE NAME: T:\42006\XL3278 - SR 202 SAHALEE PLANT EST\XL3278\CA0\PS&ESheets\For Landscape-municipal\files.dgn | | REGION: 10 WASH | | STATE: WA | | FED.AID PROJ.NO. | | PLOT 11 | |
| TIME: 5:51:43 PM | | JOB NUMBER: 04A059 | | LOCATION NO. | | DATE: | | PL11 | |
| DATE: 10/2/2008 | | CONTRACT NO. | | DATE: | | DATE: | | SHEET OF SHEETS | |
| DESIGNED BY: A. SAWICH | | REGIONAL ADM. L. ENG | | REVISION | | DATE | | BY | |
| ENTERED BY: K. McLEAN | | | | | | | | | |
| CHECKED BY: B. MacLAREN | | | | | | | | | |
| PROJ. ENGR. D. EDWARDS | | | | | | | | | |

Washington State
Department of Transportation

SR 202
SR 520 TO SAHALEE WAY STAGE 2
PLANT ESTABLISHMENT YEARS 2-4


ROADSIDE PLANTING PLAN

T.25N. R.6E. W.M.


185TH AVE NE

SR 202

AS-BUILT FOR REFERENCE ONLY

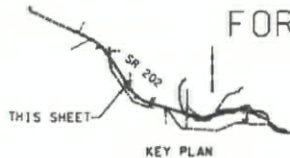


LEGEND

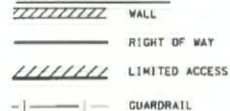

NOTES:

1. IN AREAS WITH LAWN AND STREET TREES, SEE LAWN EDGING AND TREE PIT PLANTING DETAILS, SHEET PDS.
2. SHRUBS WITHIN PLANTING MIXES OCCUR THROUGHOUT ENTIRE PLANTING AREA, INCLUDING UNDER TREES AND TREE-LIKE SHRUBS.
3. SPACE BOSTON IVY EVENLY ALONG ENTIRE PLANTING AREA.

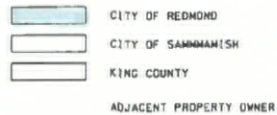

* PLANT WATANABE VIBURNUM IN GROUPS OF 3 IN A STRAIGHT LINE DOWN THE CENTER OF THE MEDIAN BETWEEN AMUR MAPLES.

** PLANT COMPACT OREGON GRAPE AND PRIVET HONEYSUCKLE IN GROUPS OF 3, 5, 7 OR 9 PLANTS

*** SETBACK DISTANCE 6" MIN. BACK OF SIDEWALK

0 20 40
SCALE IN FEET



STATE OF
WASHINGTON
REGISTERED
LANDSCAPE ARCHITECT

DAVID S. PETERSON
CERTIFICATE NO. 476
DATE: _____

SR 202
SR 520 TO SAHLEE WAY STAGE 2
PLANT ESTABLISHMENT YEARS 2-4

ROADSIDE PLANTING PLAN

| QUANTITY TAB - THIS SHEET ONLY | | | | | | | | | |
|--------------------------------|---|----------|------|-----|-----|------|--|--|--|
| SYMBOL | ITEM | QUANTITY | | | | | | | |
| MIX M - 4' O.C. | | MB | | | | | | | |
| | COMPACT OREGON GRAPE | 9 | | | | | | | |
| | WATANABE VIBURNUM * | 3 | | | | | | | |
| | BARK OR WOOD CHIP MULCH (CY) | 2.0 | | | | | | | |
| | TOPSOIL TYPE A (CY) | 7.0 | | | | | | | |
| MIX P - 4' O.C. ** | | P42 | P43 | P44 | P45 | P46 | | | |
| | COMPACT OREGON GRAPE | 10 | 3 | 2 | 5 | 9 | | | |
| | PRIVET HONEYSUCKLE | 10 | 4 | 2 | 6 | 9 | | | |
| | BARK OR WOOD CHIP MULCH (CY) | 4.0 | 1.0 | 1.0 | 2.0 | 3.0 | | | |
| | TOPSOIL TYPE A (CY) | 15.0 | 4.0 | 3.0 | 6.0 | 11.0 | | | |
| MIX R - 6' O.C. | | R8 | R9 | R10 | | | | | |
| | MOCK ORANGE | 17 | 27 | 2 | | | | | |
| | NOOTKA ROSE | 29 | 44 | 4 | | | | | |
| | OCEANSPRAY | 0 | 0 | 0 | | | | | |
| | TALL OREGON GRAPE | 35 | 53 | 4 | | | | | |
| | VINE MAPLE | 17 | 26 | 2 | | | | | |
| | WESTERN SERVICEBERRY | 17 | 27 | 3 | | | | | |
| | SOIL AMENDMENT WITH GROUND BARK (CY) | 37.0 | 57.0 | 5.0 | | | | | |
| | FINE COMPOST (CY) | 12.0 | 18.0 | 2.0 | | | | | |
| | BARK OR WOOD CHIP MULCH (CY) | 37.0 | 53.0 | 5.0 | | | | | |
| MIX K - 4' O.C. | | K5 | K6 | | | | | | |
| | COMPACT OREGON GRAPE | 47 | 131 | | | | | | |
| | 'ELMA' ROCK ROSE | 23 | 55 | | | | | | |
| | SALAL | 8 | 18 | | | | | | |
| | SOIL AMENDMENT (CY) | 11.0 | 24.0 | | | | | | |
| | FINE COMPOST (CY) | 4.0 | 8.0 | | | | | | |
| | BARK OR WOOD CHIP MULCH (CY) | 11.0 | 24.0 | | | | | | |
| MIX N - 3' O.C. *** | | N7 | | | | | | | |
| | BEACH STRAWBERRY | 9 | | | | | | | |
| | BOSTON IVY 'VEITCHII' | 1 | | | | | | | |
| | COMPACT OREGON GRAPE | 4 | | | | | | | |
| | SOIL AMENDMENT WITH GROUND BARK (CY) | 3.0 | | | | | | | |
| | FINE COMPOST (CY) | 1.0 | | | | | | | |
| | BARK OR WOOD CHIP MULCH (CY) | 3.0 | | | | | | | |
| | BURKWOOD OSMANTHUS 10' O.C. (TYP) EXCEPT AS NOTED | 1 | | | | | | | |
| | 'EMERALD QUEEN' NORWAY MAPLE 30' O.C. (TYP) | 22 | | | | | | | |
| | DOUGLAS FIR | 11 | | | | | | | |
| | KOUSA DOGWOOD | 8 | | | | | | | |

| | | | |
|---------------|---|--------------------|----|
| FILE NAME | T:\42006\XL3278 - SR 202 SAHLEE PLANT EST\XL3278\CA0\PS&ESheets\For Landscape-municipal\files.dgn | FED. AID PROJ. NO. | |
| TIME | 5:51:46 PM | | |
| DATE | 10/2/2008 | | |
| DESIGNED BY | A. SAWICH | | |
| ENTERED BY | K. McLEAN | | |
| CHECKED BY | B. MacLAREN | | |
| PROJ. ENGR. | D. EDWARDS | | |
| REGIONAL ADM. | L. ENG | | |
| REVISION | | DATE | BY |

P.E. STAMP BOX DATE

P.E. STAMP BOX SITE


Washington State
Department of Transportation








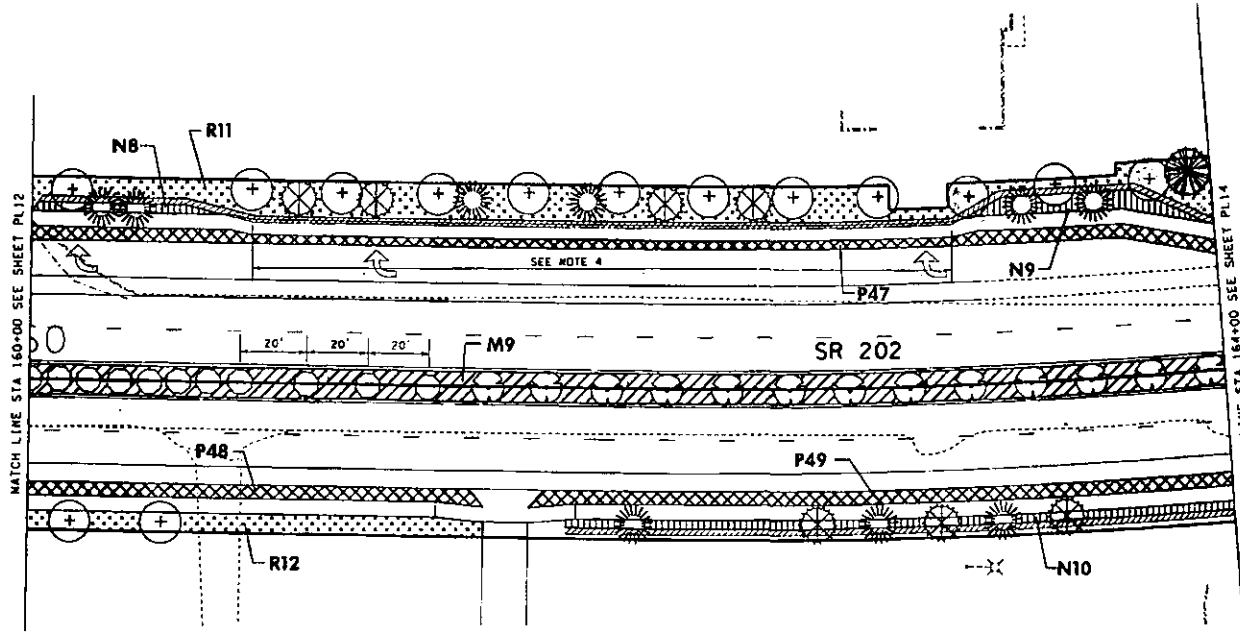


PLOT 12

PL12

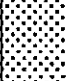SHEET
OF
SHEETS

T.25N. R.6E. W.M.



| QUANTITY TAB - THIS SHEET ONLY | | | | |
|---|---|----------|------|------|
| SYMBOL | ITEM | QUANTITY | | |
| MIX M - 6' O.C. | | M9 | | |
|  | COMPACT OREGON GRAPE | 136 | | |
| | WATANABE VIBURNUM * | 60 | | |
| | BARK OR WOOD CHIP MULCH (CY) | 37.0 | | |
| | TOPSOIL TYPE A (CY) | 122.0 | | |
| MIX P - 4' O.C. ** | | P47 | P48 | P49 |
|  | COMPACT OREGON GRAPE | 78 | 18 | 34 |
| | PRIVET HONEYSUCKLE | 20 | 18 | 34 |
| | BARK OR WOOD CHIP MULCH (CY) | 13.0 | 6.0 | 10.0 |
| | TOPSOIL TYPE A (CY) | 43.0 | 21.0 | 32.0 |
| MIX R - 8' O.C. | | R11 | R12 | |
|  | MOCK ORANGE | 10 | 4 | |
| | WITCH HAZEL | 15 | 7 | |
| | OCEANSPRAY | 0 | 0 | |
| | TALL OREGON GRAPE | 20 | 9 | |
| | VINE MAPLE | 10 | 4 | |
| | WESTERN SERVICEBERRY | 10 | 5 | |
| | SOIL AMENDMENT WITH GROUND BARK (CY) | 24.0 | 9.0 | |
| | FINE COMPOST (CY) | 8.0 | 3.0 | |
| | BARK OR WOOD CHIP MULCH (CY) | 24.0 | 9.0 | |
| MIX N - 3' O.C. *** | | N8 | N9 | N10 |
|  | BEACH STRAWBERRY | 8 | 30 | 32 |
| | BOSTON IVY 'VEITCHII' | 4 | 5 | 5 |
| | COMPACT OREGON GRAPE | 1 | 13 | 14 |
| | SOIL AMENDMENT WITH GROUND BARK (CY) | 2.0 | 16.0 | 6.0 |
| | FINE COMPOST (CY) | 1.0 | 6.0 | 2.0 |
| | BARK OR WOOD CHIP MULCH (CY) | 2.0 | 16.0 | 6.0 |
|  | BURKWOOD DSMANTHUS 10' O.C. (TYP) EXCEPT AS NOTED | 10 | | |
|  | AMUR MAPLE 20' O.C. (TYP) | 11 | | |
|  | 'EMERALD QUEEN' NORWAY MAPLE 30' O.C. (TYP) | 14 | | |
|  | DOUGLAS FIR | 1 | | |
|  | FASTIGIATE HORNBEE | 7 | | |
|  | SPRING GROVE WESTERN RED CEDAR | 9 | | |

AS-BUILT
FOR REFERENCE ONLY

NOTES:

1. IN AREAS WITH LAWN AND STREET TREES, SEE LAWN EDGING AND TREE PIT PLANTING DETAILS, SHEET PDS.
2. SHRUBS WITHIN PLANTING MIXES OCCUR THROUGHOUT ENTIRE PLANTING AREA, INCLUDING UNDER TREES AND TREE-LIKE SHRUBS.
3. SPACE BOSTON IVY EVENLY ALONG ENTIRE PLANTING AREA.
4. PLANT ONLY COMPACT OREGON GRAPE IN THIS AREA.

* PLANT WATANABE VIBURNUM IN GROUPS OF 3 IN A STRAIGHT LINE DOWN THE CENTER OF THE MEDIAN BETWEEN AMUR MAPLES.


** PLANT COMPACT OREGON GRAPE AND PRIVET HONEYSUCKLE IN GROUPS OF 3, 5, 7 OR 9 PLANTS

*** SETBACK DISTANCE 6" MIN. BACK OF SIDEWALK

LEGEND

| | | | |
|--|----------------|--|-------------------------|
| | WALL | | CITY OF REDMOND |
| | RIGHT OF WAY | | CITY OF SAMMAMISH |
| | LIMITED ACCESS | | KING COUNTY |
| | GUARDRAIL | | ADJACENT PROPERTY OWNER |

0 20 40
SCALE IN FEET

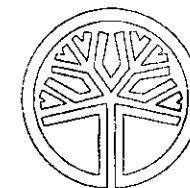


STATE OF
WASHINGTON
REGISTERED
LANDSCAPE ARCHITECT


DAVID S. PETERSON
CERTIFICATE NO. 476
DATE:

| | | | | | | | | | |
|---|--|----------------------|--|--------------------|--|-----------------|--|------------------------|--|
| FILE NAME: T:\42006\XL3278 - SR 202 SAHLEE PLANT EST\XL3278\CA0\PSAESheets\For Landscape-municipalities.dgn | | REGION: 10 WASH | | FED. AID PROJ. NO. | | DATE: 10/2/2008 | | PLOT 13 | |
| DESIGNED BY: A. SAWICH | | JOB NUMBER: 04A059 | | LOCATION NO. | | DATE: 10/2/2008 | | SHEET 11 OF 11 | |
| ENTERED BY: K. McLEAN | | CONTRACT NO. | | DATE: 10/2/2008 | | P.E. STAMP BOX | | ROADSIDE PLANTING PLAN | |
| CHECKED BY: S. MacLAREN | | REGIONAL ADM. L. ENG | | REVISION | | DATE | | BY | |

T.25N. R.6E. W.M.

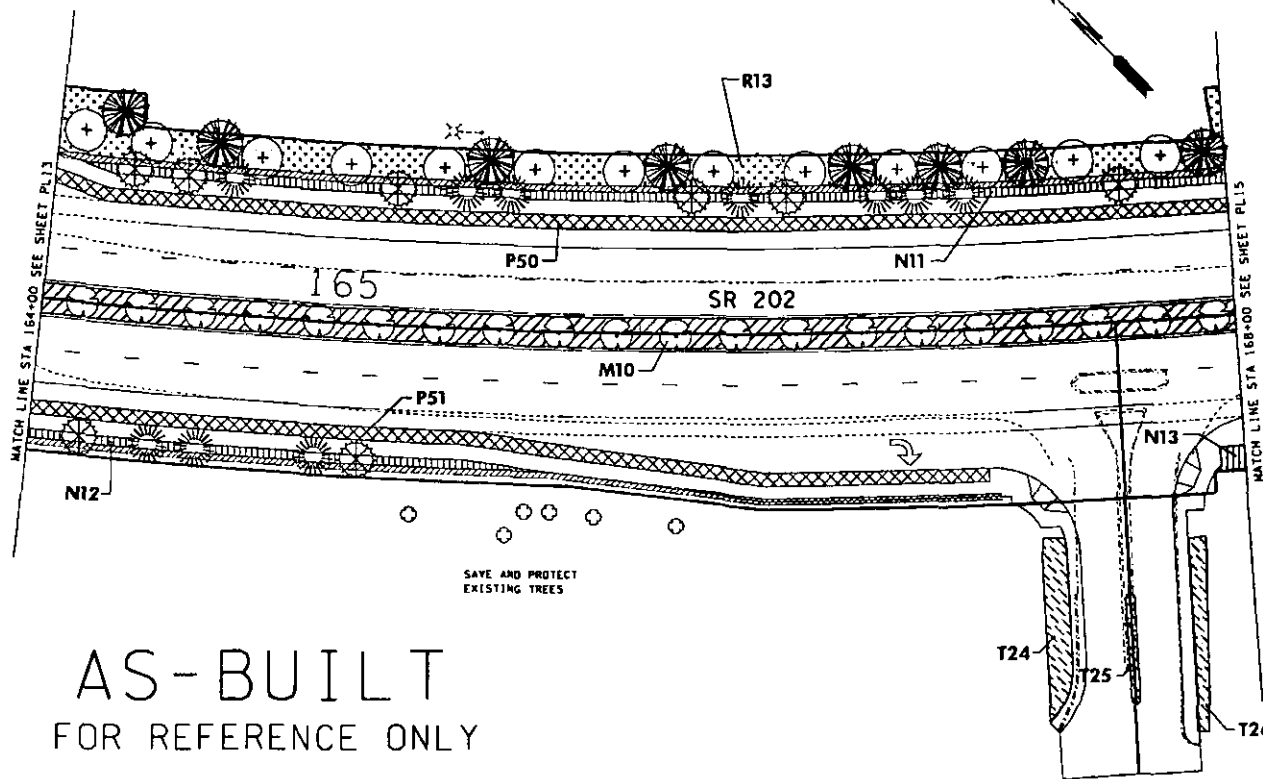

AS-BUILT
FOR REFERENCE ONLY

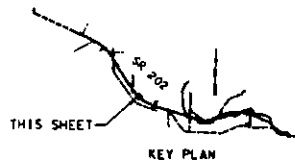

LEGEND

| | |
|--|-------------------|
| | WALL |
| | RIGHT OF WAY |
| | LIMITED ACCESS |
| | GUARDRAIL |
| | CITY OF REDMOND |
| | CITY OF SAMMAMISH |
| | KING COUNTY |


- NOTES:**
- MIX T GROUND TREATMENT VARIES TO MATCH ADJACENT LANDSCAPE. SEE QUANTITY TAB FOR AREA AND TREATMENT.
 - IN AREAS WITH LAWN AND STREET TREES, SEE LAWN EDGING AND TREE PIT PLANTING DETAILS, SHEET POS.
 - SHRUBS WITHIN PLANTING MIXES OCCUR THROUGHOUT ENTIRE PLANTING AREA, INCLUDING UNDER TREES AND TREE-LIKE SHRUBS.
 - SPACE BOSTON IVY EVENLY ALONG ENTIRE PLANTING AREA.

- * PLANT VATANABE VIBURNUM IN GROUPS OF 3 IN A STRAIGHT LINE DOWN THE CENTER OF THE MEDIAN BETWEEN AMUR MAPLES.
- ** PLANT COMPACT OREGON GRAPE AND PRIVET HONEYSUCKLE IN GROUPS OF 3, 5, 7 OR 9 PLANTS
- *** SETBACK DISTANCE 6" MIN. BACK OF SIDEWALK

0 20 40
SCALE IN FEET

QUANTITY TAB - THIS SHEET ONLY

| SYMBOL | ITEM | QUANTITY |
|-----------------|---|----------|
| MIX M - 4' O.C. | COMPACT OREGON GRAPE | 140 |
| | VATANABE VIBURNUM * | 57 |
| | BARK OR WOOD CHIP MULCH (CY) | 37.0 |
| | TOPSOIL TYPE A (CY) | 124.0 |
| MIX P - 4' O.C. | COMPACT OREGON GRAPE | 62 |
| | PRIVET HONEYSUCKLE | 52 |
| | BARK OR WOOD CHIP MULCH (CY) | 16.0 |
| | TOPSOIL TYPE A (CY) | 59.0 |
| MIX T | PRIVET HONEYSUCKLE | 16 |
| | SOIL AMENDMENT WITH GROUND BARK (CY) | 4.0 |
| | FINE COMPOST (CY) | 2.0 |
| | BARK OR WOOD CHIP MULCH (CY) | 4.0 |
| | TOPSOIL TYPE A (CY) | 0 |
| MIX R - 6' O.C. | MOCK ORANGE | 18 |
| | HOOTEA ROSE | 30 |
| | DEANS PRAY | 0 |
| | TALL OREGON GRAPE | 36 |
| | VINE MAPLE | 18 |
| | WESTERN SERVICEBERRY | 20 |
| | SOIL AMENDMENT WITH GROUND BARK (CY) | 41.0 |
| | FINE COMPOST (CY) | 14.0 |
| | BARK OR WOOD CHIP MULCH (CY) | 41.0 |
| MIX N - 3' O.C. | BEACH STRAWBERRY | 57 |
| | BOSTON IVY 'VEITCHII' | 10 |
| | COMPACT OREGON GRAPE | 24 |
| | SOIL AMENDMENT WITH GROUND BARK (CY) | 11.0 |
| | FINE COMPOST (CY) | 4.0 |
| | BARK OR WOOD CHIP MULCH (CY) | 11.0 |
| | AMUR MAPLE 20' O.C. (TYP) | 20 |
| | 'EMERALD QUEEN' NORWAY MAPLE 30' O.C. (TYP) | 13 |
| | DOUGLAS FIR | 8 |
| | FASCICATE HORNBEAM | 8 |
| | SPRING GROVE WESTERN RED CEDAR | 9 |

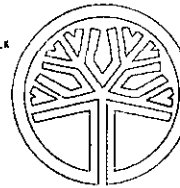

STATE OF
WASHINGTON
REGISTERED
LANDSCAPE ARCHITECT

DAVID S. PETERSON
CERTIFICATE NO. 476
DATE:

| | | | | |
|---|-------------------------------------|--------------------|--------------|--------------------|
| FILE NAME: T:\42006\XL13278 - SR 202 SAHALEE PLANT EST\XL13278\CAOVPS&S\Sheet18.dgn | ADJACENT PROPERTY OWNED BY: [Blank] | REGION NO. 10 | STATE WASH | FED. AID PROJ. NO. |
| TIME: 5:51:52 PM | | JOB NUMBER: 04A059 | | |
| DATE: 10/2/2008 | | CONTRACT NO. | LOCATION NO. | |
| DESIGNED BY: A. SAWICH | | | | |
| ENTERED BY: K. McLEAN | | | | |
| CHECKED BY: B. McLAREN | | | | |
| PROJ. ENGR. D. EDWARDS | | | | |
| REGIONAL ADM. L. ENG | | | | |
| REVISION | DATE | BY | | |

Washington State
Department of Transportation


SR 202
SR 520 TO SAHALEE WAY STAGE 2
PLANT ESTABLISHMENT YEARS 2-4

ROADSIDE PLANTING PLAN

PL14


SHEET 14 OF 15

T.25N. R.6E. W.M.

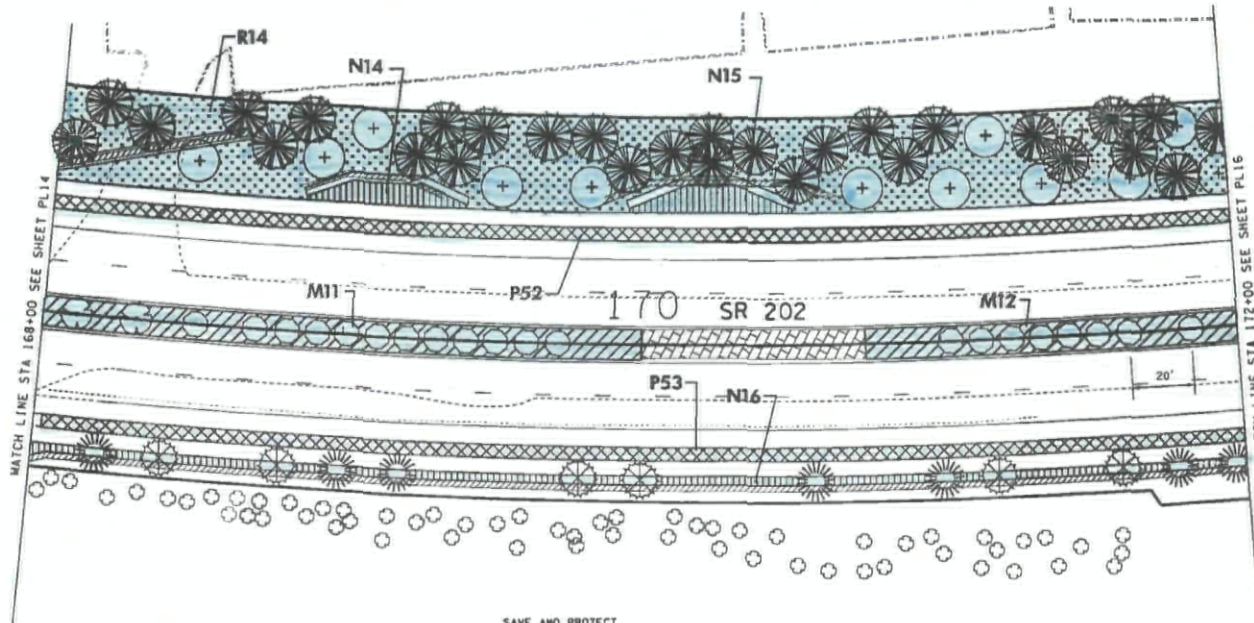

SAVE AND PROTECT
EXISTING TREES

AS-BUILT
FOR REFERENCE ONLY

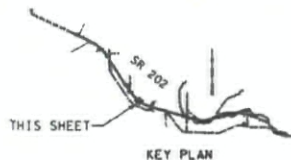

LEGEND

- WALL
- RIGHT OF WAY
- LIMITED ACCESS
- GUARDRAIL

- CITY OF REDMOND
- CITY OF SAMMAMISH
- KING COUNTY

ADJACENT PROPERTY OWNER

0 20 40
SCALE IN FEET

| QUANTITY TAB - THIS SHEET ONLY | | | |
|--------------------------------|--|----------|---------|
| SYMBOL | ITEM | QUANTITY | |
| MIX M - 4' O.C. | | M11 | M12 |
| | COMPACT OREGON GRAPE | 67 | 42 |
| | WATANABE VIBURNUM * | 27 | 18 |
| | BARK OR WOOD CHIP MULCH (CY) | 18.0 | 12.0 |
| | TOPSOIL TYPE A (CY) | 62.0 | 39.0 |
| MIX P - 4' O.C. | | P52 | P53 |
| | COMPACT OREGON GRAPE | 69 | 69 |
| | PRIVET HONEYSUCKLE | 50 | 50 |
| | BARK OR WOOD CHIP MULCH (CY) | 16.0 | 17.0 |
| | TOPSOIL TYPE A (CY) | 54.0 | 55.0 |
| MIX R - 6' O.C. | | R14 | |
| | NOCK DRANGE | 52 | |
| | NOOTKA ROSE | 87 | |
| | OCEANSPRAY | 0 | |
| | TALL OREGON GRAPE | 105 | |
| | VINE MAPLE | 52 | |
| | WESTERN SERVICEBERRY | 54 | |
| | SOIL AMENDMENT WITH GROUND BARK (CY) | 113.0 | |
| | FINE COMPOST (CY) | 38.0 | |
| | BARK OR WOOD CHIP MULCH (CY) | 113.0 | |
| MIX N - 3' O.C. | | N14 | N15 N16 |
| | BEACH STRAWBERRY | 25 | 32 57 |
| | BOSTON IVY 'VEITCHII' | | 10 |
| | COMPACT OREGON GRAPE | 10 | 14 24 |
| | SOIL AMENDMENT WITH GROUND BARK (CY) | 3 | 3 11.0 |
| | FINE COMPOST (CY) | 1 | 1 4.0 |
| | BARK OR WOOD CHIP MULCH (CY) | 3 | 3 11.0 |
| | BURKWOOD OSMANTHUS 10' O.C. (TYP) EXCEPT AS NOTED | 20 | |
| | AMUR MAPLE 20' O.C. (TYP) | 2 | |
| | 'EMERALD QUEEN' NORWAY MAPLE 30' O.C. (TYP) | 13 | |
| | DOUGLAS FIR | 29 | |
| | FASTIGIATE HORNBEE | 6 | |
| | SPRING GROVE WESTERN RED CEDAR | 6 | |

* PLANT WATANABE VIBURNUM IN GROUPS OF 3 IN A STRAIGHT LINE DOWN THE CENTER OF THE MEDIAN BETWEEN AMUR MAPLES.

** PLANT COMPACT OREGON GRAPE AND PRIVET HONEYSUCKLE IN GROUPS OF 3, 5, 7 OR 9 PLANTS

*** SETBACK DISTANCE 6" MIN. BACK OF SIDEWALK



STATE OF
WASHINGTON
REGISTERED
LANDSCAPE ARCHITECT

DAVID S. PETERSON
CERTIFICATE NO. 476
DATE: _____

FILE NAME: T:\42006\XL3278 - SR 520 SAHALEE PLANT EST\XL3278\CAO\PSA\Sheet\For Landscape-municipal\files.dgn
TIME: 5:51:54 PM
DATE: 10/2/2008

DESIGNED BY: A. SAWICH
ENTERED BY: K. McLEAN
CHECKED BY: B. MacLAREN
PROJ. ENGR.: D. EDWARDS
REGIONAL ADM.: L. ENG

REVISION

DATE

BY

REGION NO. 10
STATE WASH
JOB NUMBER 04A059
CONTRACT NO.

FED. AID PROJ. NO.

LOCATION NO.

P.E. STAMP BOX

DATE

P.E. STAMP BOX

DATE

Washington State
Department of Transportation

SR 520
SR 520 TO SAHALEE WAY STAGE 2
PLANT ESTABLISHMENT YEARS 2-4

ROADSIDE PLANTING PLAN

PLOT 15


PL75

SHEET


OF

SHEETS

T.25N. R.6E. W.M.

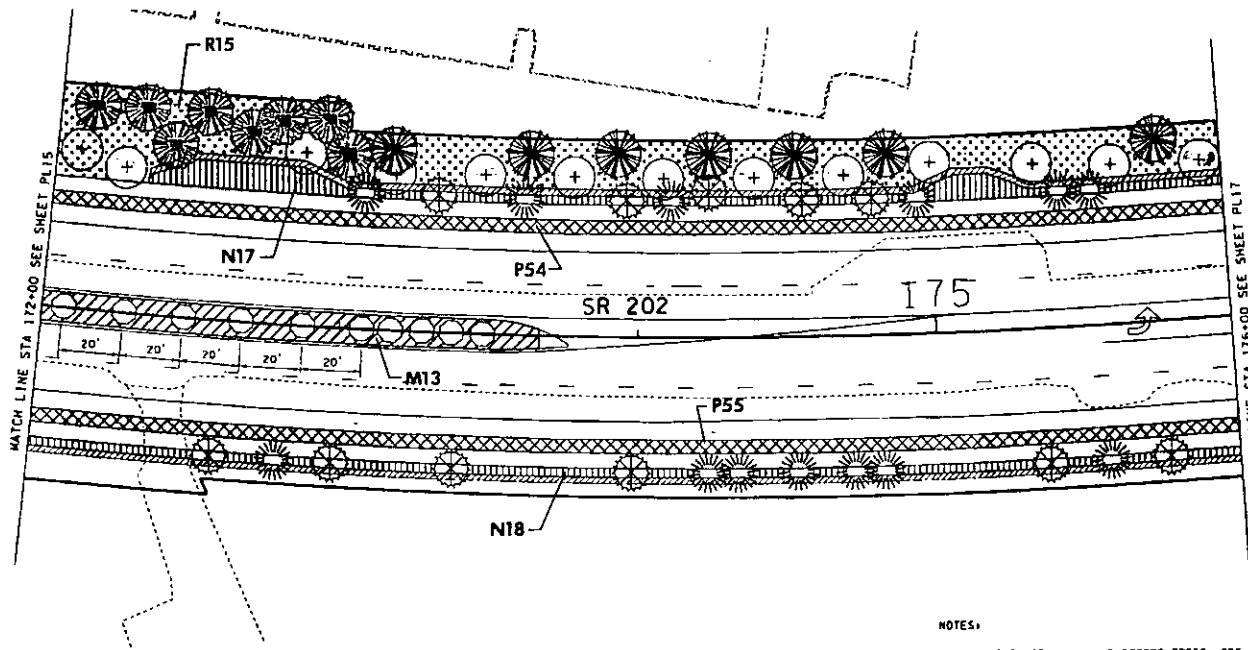

AS-BUILT
FOR REFERENCE ONLY

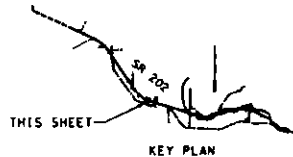

| LEGEND | |
|--------|----------------|
| | WALL |
| | RIGHT OF WAY |
| | LIMITED ACCESS |
| | GUARDRAIL |


| | |
|--|-------------------------|
| | CITY OF REDMOND |
| | CITY OF SAMMAMISH |
| | KING COUNTY |
| | ADJACENT PROPERTY OWNER |

0 20 40
SCALE IN FEET

| QUANTITY TAB - THIS SHEET ONLY | | |
|--------------------------------|---|-----------|
| SYMBOL | ITEM | QUANTITY |
| MIX M - 4" O.C. | | M13 |
| | COMPACT OREGON GRAPE | 65 |
| | WATANABE VIBURNUM * | 27 |
| | BARK OR WOOD CHIP MULCH (CY) | 10.0 |
| | TOPSOIL TYPE A (CY) | 32.0 |
| MIX P - 4" O.C. ** | | P54 P55 |
| | COMPACT OREGON GRAPE | 59 59 |
| | PRIVET HONEYSUCKLE | 50 50 |
| | BARK OR WOOD CHIP MULCH (CY) | 16.0 17.0 |
| | TOPSOIL TYPE A (CY) | 54.0 57.0 |
| MIX R - 6" O.C. | | R15 |
| | MOCK ORANGE | 32 |
| | HOOTKA ROSE | 54 |
| | OCEANSPRAY | 0 |
| | TALL OREGON GRAPE | 65 |
| | VINE MAPLE | 32 |
| | WESTERN SERVICEBERRY | 32 |
| | SOIL AMENDMENT WITH GROUND BARK (CY) | 70.0 |
| | FINE COMPOST (CY) | 23.0 |
| | BARK OR WOOD CHIP MULCH (CY) | 70.0 |
| MIX N - 3" O.C. *** | | N17 N18 |
| | BEACH STRAWBERRY | 52 47 |
| | BOSTON IVY 'VEITCHII' | 8 8 |
| | COMPACT OREGON GRAPE | 22 20 |
| | SOIL AMENDMENT WITH GROUND BARK (CY) | 10.0 11.0 |
| | FINE COMPOST (CY) | 3.0 4.0 |
| | BARK OR WOOD CHIP MULCH (CY) | 10.0 11.0 |
| | BURNING BUSH (10' O.C. (TYP) EXCEPT AS NOTED) | 10 |
| | 'EMERALD QUEEN' NORWAY MAPLE 30' O.C. (TYP) | 13 |
| | DOUGLAS FIR | 15 |
| | FASTIGIATE NORDBEAM | 11 |
| | SPRING GROVE WESTERN RED CEDAR | 11 |

- NOTES:
1. IN AREAS WITH LAWN AND STREET TREES, SEE LAWN EDGING AND TREE PIT PLANTING DETAILS, SHEET PDS.
 2. SHRUBS WITHIN PLANTING MIXES OCCUR THROUGHOUT ENTIRE PLANTING AREA, INCLUDING UNDER TREES AND TREE-LIKE SHRUBS.
 3. SPACE BOSTON IVY EVENLY ALONG ENTIRE PLANTING AREA.

* PLANT WATANABE VIBURNUM IN GROUPS OF 3 IN A STRAIGHT LINE DOWN THE CENTER OF THE MEDIAN BETWEEN AMUR MAPLES.
 ** PLANT COMPACT OREGON GRAPE AND PRIVET HONEYSUCKLE IN GROUPS OF 3, 5, 7 OR 9 PLANTS
 *** SETBACK DISTANCE 6" MIN. BACK OF SIDEWALK

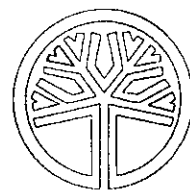


STATE OF WASHINGTON
REGISTERED
LANDSCAPE ARCHITECT

DAVID S. PETERSON
CERTIFICATE NO. 476
DATE: _____

| | | | | | | | | | | | | |
|---|--|--|--|------------------------|--|------------------------|--|----------------------|--|------------------------|--|-----------|
| FILE NAME: T:\42006\XL3278 - SR 202 SAHAFEE PLANT EST\XL3278\CAD\PS&ESheets\For Landscape-municipal\11a.dgn | | | | FED. AID PROJ. NO. | | P.L. STAMP BOX | | P.L. STAMP BOX | | ROADSIDE PLANTING PLAN | | PL16 |
| TIME: 5:51:58 PM | | | | TO WASH | | DATE | | DATE | | SHEET | | OF SHEETS |
| DATE: 10/27/2008 | | | | JOB NUMBER: 04A059 | | CONTRACT NO. | | LOCATION NO. | | ROADSIDE PLANTING PLAN | | |
| DESIGNED BY: A. SAWICH | | | | CHECKED BY: B. McLEARN | | PROJ. ENCR. D. EDWARDS | | REGIONAL ADM. L. ENG | | REVISION | | |
| ENTERED BY: K. McLEARN | | | | DATE | | BY | | | | | | |



T.25N. R.6E. W.M.

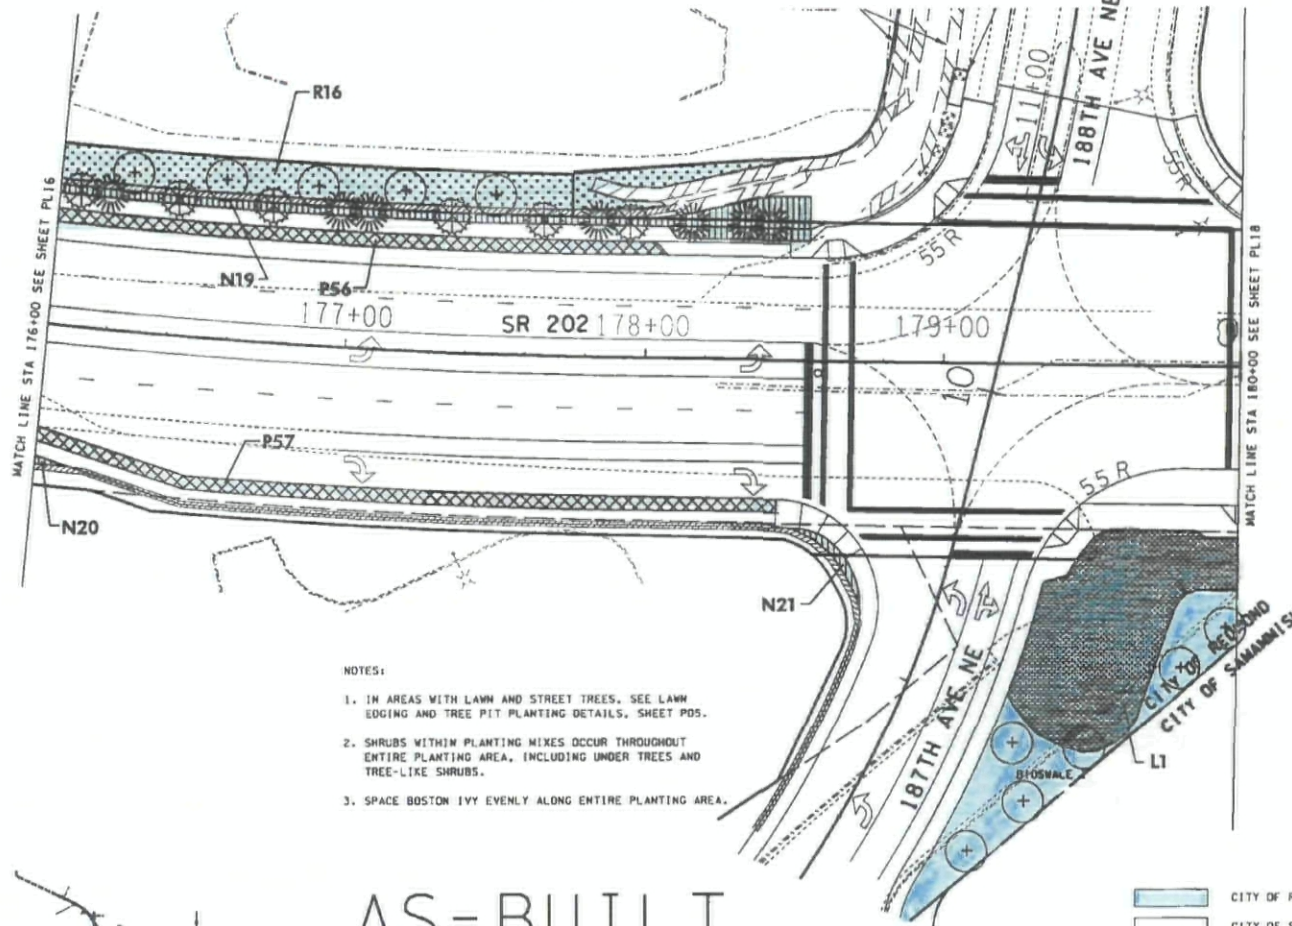

NOTES:

1. IN AREAS WITH LAWN AND STREET TREES, SEE LAWN EDGING AND TREE PIT PLANTING DETAILS, SHEET PDS.
2. SHRUBS WITHIN PLANTING MIXES OCCUR THROUGHOUT ENTIRE PLANTING AREA, INCLUDING UNDER TREES AND TREE-LIKE SHRUBS.
3. SPACE BOSTON IVY EVENLY ALONG ENTIRE PLANTING AREA.

AS-BUILT
FOR REFERENCE ONLY

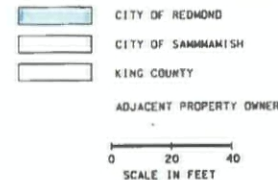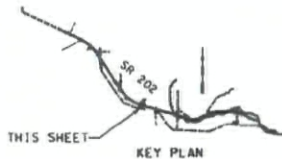

| QUANTITY TAB - THIS SHEET ONLY | | | | |
|--------------------------------|---|----------|------|-----|
| SYMBOL | ITEM | QUANTITY | | |
| MIX P - 4' O.C. | ** | P56 | P57 | |
| | COMPACT OREGON GRAPE | 21 | 25 | |
| | PRIVET HONEYSUCKLE | 22 | 25 | |
| | BARK OR WOOD CHIP MULCH (CY) | 10.0 | 10.0 | |
| | TOPSOIL TYPE A (CY) | 34.0 | 35.0 | |
| MIX R - 6' O.C. | | R16 | | |
| | MOCK ORANGE | 11 | | |
| | MOCKA ROSE | 19 | | |
| | OCEANSPRAY | 0 | | |
| | TALL OREGON GRAPE | 21 | | |
| | VINE MAPLE | 11 | | |
| | WESTERN SERVICEBERRY | 11 | | |
| | SOIL AMENDMENT WITH GROUND BARK (CY) | 19.5 | | |
| | FINE COMPOST (CY) | 6.0 | | |
| | BARK OR WOOD CHIP MULCH (CY) | 19.5 | | |
| MIX N - 3' O.C. | *** | N19 | N20 | N21 |
| | BEACH STRAWBERRY | 40 | 2 | 5 |
| | BOSTON IVY 'VEITCHII' | 8 | 0 | 1 |
| | COMPACT OREGON GRAPE | 18 | 0 | 0 |
| | SOIL AMENDMENT WITH GROUND BARK (CY) | 6.0 | 0.5 | 1.0 |
| | FINE COMPOST (CY) | 2.0 | 0.5 | 0.5 |
| | BARK OR WOOD CHIP MULCH (CY) | 6.0 | 0.5 | 1.0 |
| MIX L - 5' O.C. | | L1 | | |
| | BEAKED HAZELNUT | 40 | | |
| | RED ELDERBERRY | 50 | | |
| | RED-OSIER DOGWOOD | 50 | | |
| | SOIL AMENDMENT WITH GROUND BARK (CY) | 32 | | |
| | FINE COMPOST (CY) | 10 | | |
| | BARK OR WOOD CHIP MULCH (CY) | 32 | | |
| | BIOFILTRATION SWALE SEED (AC) | 0.08 | | |
| + | 'EMERALD QUEEN' NORWAY MAPLE 30' O.C. (1TP) | 11 | | |
| ⊗ | FASTIGIATE HORNBEAM | 6 | | |
| ☀ | SPRING GROVE WESTERN RED CEDAR | 7 | | |

** PLANT COMPACT OREGON GRAPE AND PRIVET HONEYSUCKLE IN GROUPS OF 3, 5, 7 OR 9 PLANTS

*** SETBACK DISTANCE 6" MIN. BACK OF SIDEWALK




STATE OF
WASHINGTON
REGISTERED
LANDSCAPE ARCHITECT

DAVID S. PETERSON
CERTIFICATE NO. 476
DATE:

| | | | | | | | | | | | |
|--|--|--|--|------------------------|--|----------------------|--|----------------|--|------------------|--|
| FILE NAME: T:\42006\XL3278 - SR 202 SAHALEE PLANT EST\XL3278\CA0\PS&ESheets\For Landscape-municipal\es.dgn | | REGION: 10 WASH | | STATE: WASH | | FED. AID PROJ. NO. | | PROJECT NO. | | PLOT 17 | |
| TIME: 5:52:01 PM | | JOB NUMBER: 04A059 | | LOCATION NO. | | DATE | | P.E. STAMP BOX | | P.L.T. STAMP BOX | |
| DATE: 10/2/2008 | | CONTRACT NO. | | DATE | | BY | | DATE | | BY | |
| DESIGNED BY: A. SAWICH | | CHECKED BY: B. MacLAREN | | PROJ. ENGR. D. EDWARDS | | REGIONAL ADM. L. ENG | | REVISION | | DATE | |
| ENTERED BY: K. McLEAN | | DATE | | BY | | DATE | | BY | | DATE | |
| Washington State Department of Transportation | | SR 202 SR 520 TO SAHALEE WAY STAGE 2 PLANT ESTABLISHMENT YEARS 2-4 | | ROADSIDE PLANTING PLAN | | SHEET OF SHEETS | | PL17 | | SHEET OF SHEETS | |

T.25N. R.6E. W.M.

SEE SHEETS PL35, PL36 AND PL37
FOR THE FLOOD PLAIN MITIGATION SITE

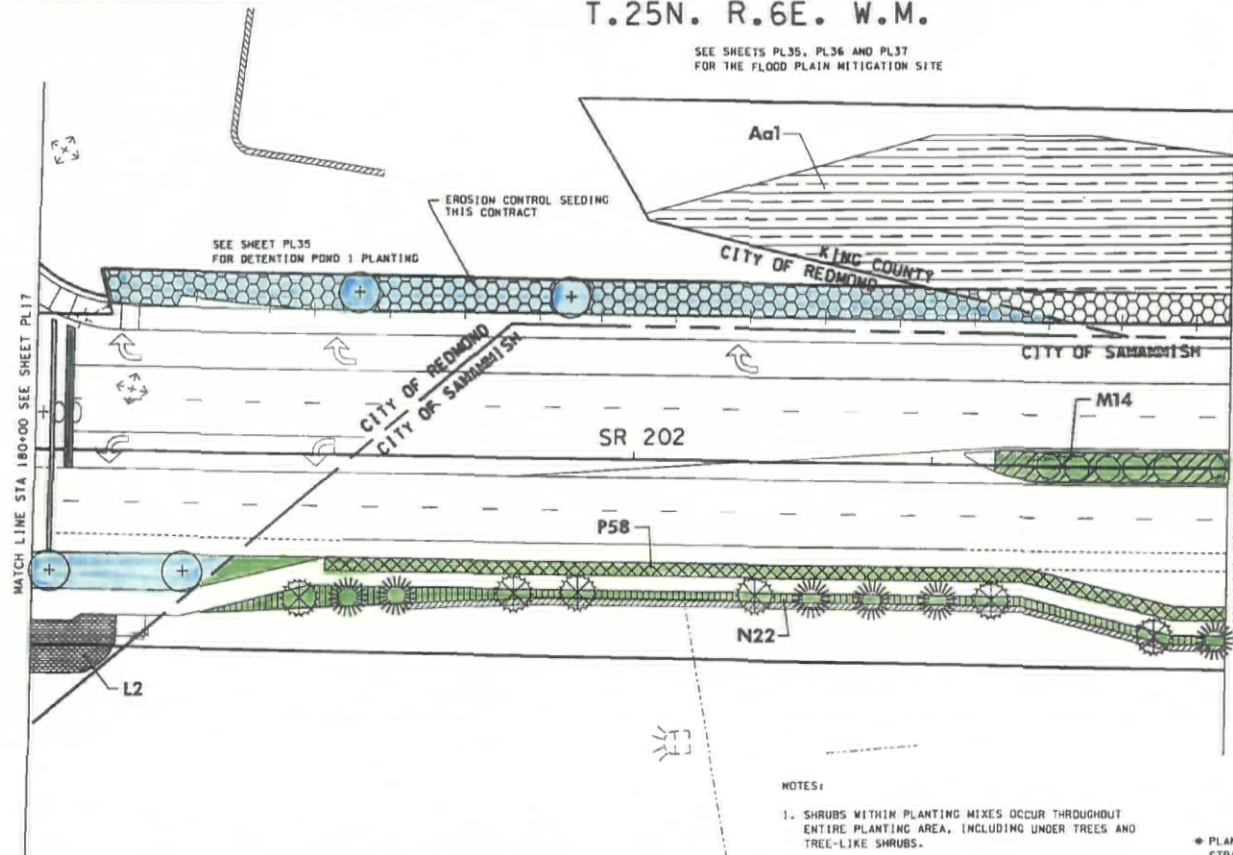

NOTES:

1. SHRUBS WITHIN PLANTING MIXES OCCUR THROUGHOUT ENTIRE PLANTING AREA, INCLUDING UNDER TREES AND TREE-LIKE SHRUBS.
2. SPACE BOSTON IVY EVENLY ALONG ENTIRE PLANTING AREA.

* PLANT VATANABE VIBURNUM IN GROUPS OF 3 IN A STRAIGHT LINE DOWN THE CENTER OF THE MEDIAN BETWEEN AMUR MAPLES.

** PLANT COMPACT OREGON GRAPE AND PRIVET HONEYSUCKLE IN GROUPS OF 3, 5, 7 OR 9 PLANTS

*** SETBACK DISTANCE 6" MIN. BACK OF SIDEWALK

AS-BUILT
FOR REFERENCE ONLY

LEGEND

- WALL
- RIGHT OF WAY
- LIMITED ACCESS
- GUARDRAIL

- CITY OF REDMOND
- CITY OF SAMMISH
- KING COUNTY

ADJACENT PROPERTY OWNER


0 20 40
SCALE IN FEET




STATE OF
WASHINGTON
REGISTERED
LANDSCAPE ARCHITECT





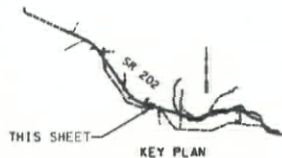

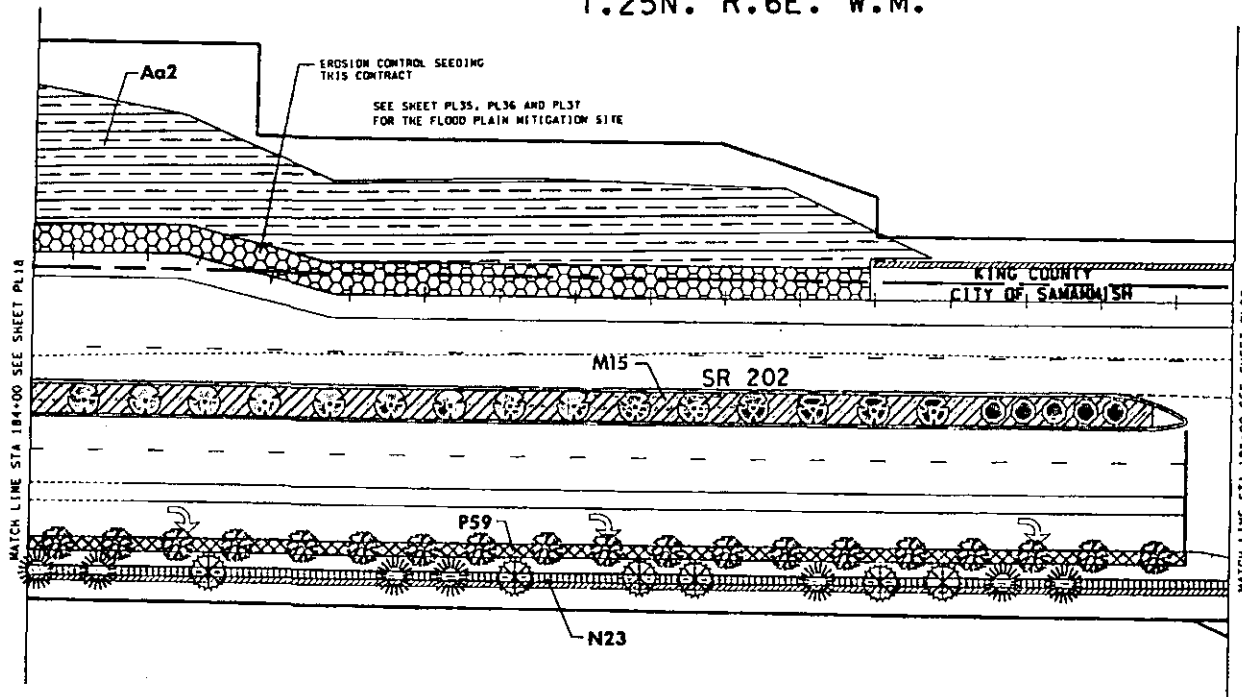


 








DAVID S. PETERSON
CERTIFICATE NO. 476
DATE:

| QUANTITY TAB - THIS SHEET ONLY | | |
|--------------------------------|--|----------|
| SYMBOL | ITEM | QUANTITY |
| MIX M - 4' O.C. | | M14 |
| | COMPACT OREGON GRAPE | 28 |
| | VATANABE VIBURNUM * | 12 |
| | BARK OR WOOD CHIP MULCH (CY) | 7.0 |
| | TOPSOIL TYPE A (CY) | 25.0 |
| MIX P - 4' O.C. | | P58 |
| | COMPACT OREGON GRAPE | 30 |
| | PRIVET HONEYSUCKLE | 30 |
| | BARK OR WOOD CHIP MULCH (CY) | 12.0 |
| | TOPSOIL TYPE A (CY) | 42.0 |
| MIX N - 3' O.C. | | N22 |
| | BEACH STRAWBERRY | 51 |
| | BOSTON IVY 'VEITCHII' | 8 |
| | COMPACT OREGON GRAPE | 22 |
| | SOIL AMENDMENT WITH GROUND BARK (CY) | 11.0 |
| | FINE COMPOST (CY) | 4.0 |
| | BARK OR WOOD CHIP MULCH (CY) | 11.0 |
| MIX AO - 5' O.C. | | M1 |
| | DOUGLAS FIR | 36 |
| | WESTERN HEMLOCK | 36 |
| | SHOEBERRY (BARE ROOT) | 72 |
| | BALDIP ROSE | 36 |
| | RED ELDERBERRY | 72 |
| | CASCARA | 72 |
| | WESTERN SERVICEBERRY | 36 |
| | SOIL AMENDMENT WITH COMPOST (CY) | 72 |
| | FINE COMPOST (CY) | 24 |
| | BARK OR WOOD CHIP MULCH (CY) | 72 |
| MIX L - 5' O.C. | | L2 |
| | BEAKED HAZELNUT | 6 |
| | RED ELDERBERRY | 7 |
| | RED-OSIER DOGWOOD | 7 |
| | SOIL AMENDMENT WITH GROUND BARK (CY) | 5 |
| | FINE COMPOST (CY) | 2 |
| | BARK OR WOOD CHIP MULCH (CY) | 5 |
| | BIOFILTRATION SWALE SEED (AC) | 0.01 |
| | BURKWOOD OSMANTHUS 10' O.C. (TYP) EXCEPT AS NOTED | 5 |
| | AMUR MAPLE 20' O.C. (TYP) | 1 |
| | FASTIGIATE HORNBEEAM | 6 |
| | SPRING GROVE WESTERN RED CEDAR | 6 |
| | 'EMERALD QUEEN' NORWAY MAPLE 30' O.C. (TYP) | 4 |



| | | | | | |
|--|-----------------|------------------------|-----------------------|------------------------|-------------------------|
| FILE NAME: T:\42006\XL3278 - SR 202 SAHLEE PLANT EST\XL3278\CAD\PS&ESheets\For Landscape\municipal\lites.dgn | | FED.AID PROJ.NO. | | PLOT18 | |
| TIME: 6:37:02 PM | DATE: 10/2/2008 | DESIGNED BY: A. SAWICH | ENTERED BY: K. McLEAN | CHECKED BY: B. McLAREN | PROJ. ENGR.: D. EDWARDS |
| REGIONAL ADM. L. ENG | REVISION | DATE | BY | | |
| JOB NUMBER: 04A059 | | CONTRACT NO. | | LOCATION NO. | |
| WASH STATE NO. 10 | | DATE | | P.E. STAMP BOX | |
| WASHINGTON STATE DEPARTMENT OF TRANSPORTATION | | DATE | | P.E. STAMP BOX | |
| SR 202 SR 520 TO SAHLEE WAY STAGE 2 PLANT ESTABLISHMENT YEARS 2-4 | | | | ROADSIDE PLANTING PLAN | |
| | | | | SHEET OF SHEETS | |








| QUANTITY TAB - THIS SHEET ONLY | | |
|---|--|----------|
| SYMBOL | ITEM | QUANTITY |
| MIX M - 4' O.C. | | M15 |
|  | COMPACT OREGON GRAPE | 130 |
|  | WATANABE VIBURNUM | 54 |
| BARK OR WOOD CHIP MULCH (CY) | | 35.0 |
| TOPSOIL TYPE A (CY) | | 116.0 |
| MIX P - 4' O.C. | | P59 |
|  | COMPACT OREGON GRAPE | 57 |
|  | PRIVET HONEYSUCKLE | 57 |
| BARK OR WOOD CHIP MULCH (CY) | | 16.0 |
| TOPSOIL TYPE A (CY) | | 54.0 |
| MIX N - 3' O.C. | | N23 |
|  | BEACH STRAWBERRY | 56 |
|  | BOSTON IVY 'VEITCHII' | 10 |
|  | COMPACT OREGON GRAPE | 24 |
| SOIL AMENDMENT WITH GROUND BARK (CY) | | 11.0 |
| TYPE COMPOST (CY) | | 4.0 |
| BARK OR WOOD CHIP MULCH (CY) | | 11.0 |
| MIX Aa - 5' O.C. | | Aa2 |
|  | DOUGLAS FIR | 32 |
|  | WESTERN HULLOCK | 40 |
|  | SNOWBERRY (BARK ROOT) | 12 |
|  | BALCHIP ROSE | 40 |
|  | RED ELDERBERRY | 10 |
|  | CASCARA | 12 |
|  | WESTERN SERVICEBERRY | 40 |
| SOIL AMENDMENT WITH COMPOST (CY) | | 73.0 |
| TYPE COMPOST (CY) | | 25.0 |
| BARK OR WOOD CHIP MULCH (CY) | | 19.0 |
|  | BURNING WOOD OSMANTHUS 10' O.C. (1TP) EXCEPT AS NOTED | 5 |
|  | AMUR MAPLE 20' O.C. (1TP) | 15 |
|  | FASTIGIATE HORNBEAM | 6 |
|  | SPRING GROVE WESTERN RED CEDAR | 7 |

--- SETBACK DISTANCE 6" MIN.
BACK OF SIDEWALK

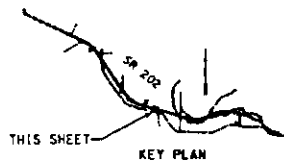AS-BUILT
FOR REFERENCE ONLY


1. SHRUBS WITHIN PLANTING MIXES OCCUR THROUGHOUT ENTIRE PLANTING AREA, INCLUDING UNDER TREES AND TREE-LIKE SHRUBS.
2. SPACE BOSTON IVY EVENLY ALONG ENTIRE PLANTING AREA.




| | |
|---|----------------|
|  | WALL |
|  | RIGHT OF WAY |
|  | LIMITED ACCESS |
|  | GUARDRAIL |

CITY OF REDMOND
 CITY OF SAMMAMISH
 KING COUNTY
 ADJACENT PROPERTY OWNER


0 20 40
SCALE IN FEET

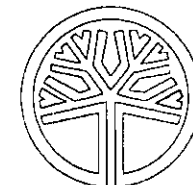


DAVID S. PETERSON
CERTIFICATE NO. 476
DATE: _____



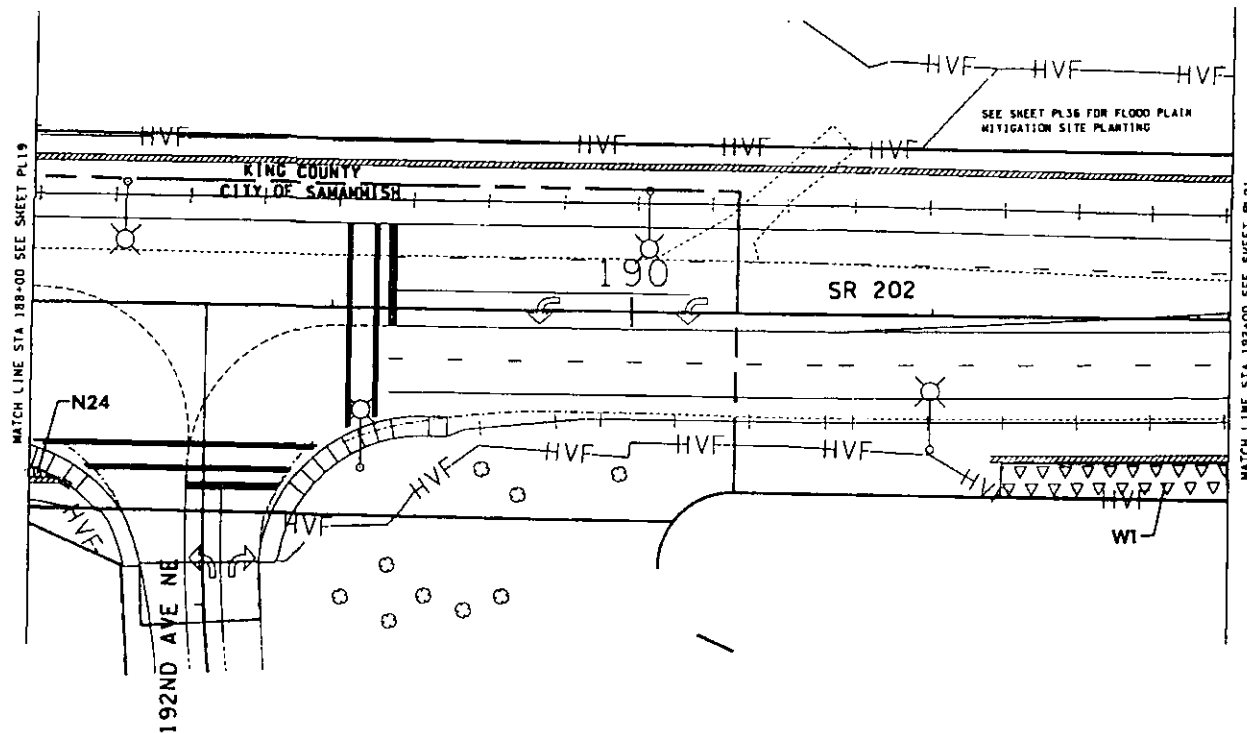

 

 


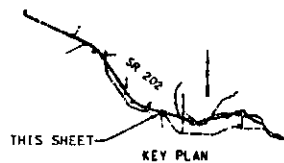

 

 
| | | | | | | | | | | |
|---------------|--|--|--|------------------|--|---|--|--|--|---|
| FILE NAME | Y:\42006\XL3278 - SH 202 SAHALEE PLANT EST\XL3278\CAD\PS&ES\sheet\For Landscape.mxd\c:\p011ies.dgn | | | FED.AID PROJ.NO. | |  Washington State Department of Transportation | | SR 202 SR 520 TO SAHALEE WAY STAGE 2 PLANT ESTABLISHMENT YEARS 2-4 | | PL0119 PL19 SHEET 1 OF SHEET 16 |
| TIME | 5:52:07 PM | | | 10 WASH | | | | | | |
| DATE | 10/22/2008 | | | 04A059 | | | | | | |
| DESIGNED BY | A. SAWICH | | | CORRECT NO. | | | | | | |
| ENTERED BY | K. McLEAN | | | LOCATION NO. | | | | | | |
| CHECKED BY | B. McLAUREN | | | | | | | | | |
| PROJ. ENGR. | D. EDWARDS | | | | | | | | | |
| REGIONAL ADM. | LENG | | | | | | | | | |
| REVISION | DATE BY | | | | | | | | | |
| | | | | | | | | | | |

T.25N. R.6E. W.M.



AS-BUILT
FOR REFERENCE ONLY



| QUANTITY TAB - THIS SHEET ONLY | | |
|---|-----------------------|----------|
| SYMBOL | ITEM | QUANTITY |
| MIK 'N' - 5' O.C. *** | | W24 |
|  | BENCH STRAWBERRY | 3 |
|  | BOSTON IVY 'VEITCHII' | 1 |
| SOIL AMENDMENT WITH GROUND BARK (CY) | | 0.5 |
| FINE COMPOST (CY) | | 0.5 |
| BARK OR WOOD CHIP MULCH (CY) | | 0.5 |
| MIK W - 5' O.C. | | W1 |
|  | DREGON ASH | 0 |
|  | PACIFIC WILLOW | 0 |
|  | SITRA SPRUCE | 0 |
|  | WESTERN RED CEDAR | 0 |
|  | BLACK TWIMBERRY | 3 |
|  | CECORA | 0 |
|  | PACIFIC KIMBARK | 0 |
|  | PEAFEY ROSE | 5 |
|  | RED-OSIER DOGWOOD | 0 |
|  | SALMONBERRY | 3 |
|  | SITRA 'S' WILLOW | 5 |
|  | SITRA WILLOW (L.S.) | 0 |
| SOIL AMENDMENT WITH FINE COMPOST (CY) | | 4.0 |
| FINE COMPOST (CY) | | 1.5 |
| BARK OR WOOD CHIP MULCH (CY) | | 4.0 |


*** SETBACK DISTANCE 6" MIN. BACK OF SIDEWALK

NOTE:

1. SPACE BOSTON IVY EVENLY ALONG ENTIRE PLANTING AREA.
2. L.S. MEANS LIVE STAKES.

LEGEND

-
- Diagram illustrating the layout of a railroad right-of-way and adjacent property owners:
- WALL**: Located at the top left of the diagram.
 - RIGHT OF WAY**: Indicated by a horizontal line with diagonal hatching above it.
 - LIMITED ACCESS**: Indicated by a horizontal line with diagonal hatching below it.
 - GUARDRAIL**: Indicated by a horizontal line with a central vertical line and short horizontal segments at each end.
 - CITY OF REDMOND**: Indicated by a rectangular box below the guardrail.
 - CITY OF SAMMAMISH**: Indicated by a rectangular box below the City of Redmond box.
 - KING COUNTY**: Indicated by a rectangular box below the City of Sammamish box.
 - ADJACENT PROPERTY OWNERS**: Indicated by a horizontal line at the bottom of the diagram.

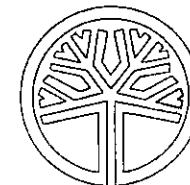

STATE OF
WASHINGTON.
REGISTERED
LANDSCAPE ARCHITECT

DAVID S. PETERSON
CERTIFICATE NO. 476
DATE: _____

0 20 40
SCALE IN FEET

[illegible]

EXHIBIT B:
ANNUAL MAINTENANCE SCHEDULE
State Route 202 - City of Sammamish Landscaping and Irrigation

| FREQUENCY BY MONTH | | | | | | | | | | | | | |
|--|-----|-----|-----|-----|-----------|-----------|-----|-----|-----|-----|-----|-----|-------------|
| | Jan | Feb | Mar | Apr | May | Jun | Jul | Aug | Sep | Oct | Nov | Dec | Total Times |
| TURF | | | | | | | | | | | | | |
| Mowing - irrigated areas | | | | | | NIC | | | | | | | 0 |
| Mowing - non irrigated areas | | | | | | NIC | | | | | | | 0 |
| Weedeating | | | | | | NIC | | | | | | | 0 |
| Edging | | | | | | NIC | | | | | | | 0 |
| Fertilizer - irrigated areas | | | | | | NIC | | | | | | | 0 |
| Fertilizer - non irrigated areas | | | | | | NIC | | | | | | | 0 |
| Herbicide | | | | | | NIC | | | | | | | 0 |
| | | | | | | | | | | | | | |
| TREES, SHRUBS & GROUND COVER BEDS | | | | | | | | | | | | | |
| Weeding | | | 1 | 1 | 1 | 1 | 1 | 1 | 1 | 1 | | | 8 |
| Groundcover Trimming | | | | 1 | | | | 1 | | | | | 2 |
| Pruning of Shrubs | | | | 1 | | | | | 1 | | | | 2 |
| Pruning Trees | | | | | As Needed | | | | | | | | 0 |
| Tree Sucker Removal | | | | | As Needed | | | | | | | | 0 |
| Fertilization | | | | 1 | | | | | | | | | 1 |
| Pre-emergent Herbicide | | | 1 | | | | | | 1 | | | | 2 |
| | | | | | | | | | | | | | |
| HARD SURFACES | | | | | | | | | | | | | |
| Sweeping/Blowing | | 1 | | 1 | | 1 | | 1 | | 1 | 1 | 1 | 7 |
| Weeds | | | 1 | 1 | 1 | 1 | 1 | 1 | 1 | 1 | | | 8 |
| | | | | | | | | | | | | | |
| IRRIGATION | | | | | | | | | | | | | 0 |
| Spring Activation | | | | 1 | | | | | | | | | |
| Maintenance | | | | 1 | 1 | 2 | 2 | 2 | 1 | | | | 9 |
| Repairs | | | | | | AS NEEDED | | | | | | | |
| Winterization | | | | | | | | | | 1 | | | 1 |
| | | | | | | | | | | | | | |
| OTHER | | | | | | | | | | | | | |
| Leaf Removal | | | | | | | | | | 1 | 1 | 1 | 3 |
| Litter | | 1 | 1 | 1 | 1 | 1 | 1 | 1 | 1 | 1 | 1 | 1 | 11 |
| Brush Control | | | | | As Needed | | | | | | | | 0 |
| Windfall Debris | | | | | As Needed | | | | | | | | 0 |
| Manual Watering | | | | | | NIC | | | | | | | 0 |